


USE TYPEWRITER OR BALL POINT PEN—PRESS FIRMLY, PRINT CLEARLY.

WATER WELL RECORD
KSA 82a-1201-1215

Kansas Department of Health and Environment—Division of Environment (Water well Contractors)
Topeka, Kansas 66620

1. Location of well: County Marshall Fraction SW 1/4 SW 1/4 SW 1/4 Section number 33 Township number T 2 South Range number Range 7 E

2. Distance and direction from nearest town or city: 1 mi south of Marysville 1/4 West Street address of well location if in city: Marysville 1/4 West
3. Owner of well: James Cohorst
R.R. or street: Marysville Kans 66508
City, state, zip code: Marysville Kans 66508

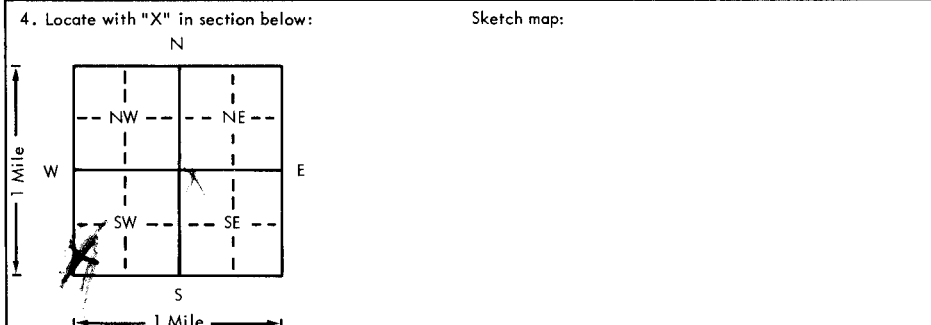

6. Bore hole dia. 9 1/2 in. Completion date 4-28-76
Well depth 96 ft.
7. Cable tool Rotary Driven Dug
 Hollow rod Jetted Bored Reverse rotary
8. Use: Domestic Public supply Industry
 Irrigation Air conditioning Stock
 Lawn Oil field water Other
9. Casing: Material Steel Height: Above of below MHC
Threaded Welded Surface T5 in.
RMP 4 PVC Weight 2.4 lbs./ft.
Dia. 5 in. to 34 ft. depth Wall Thickness: inches of 1/4
Dia. 5 in. to 96 ft. depth gage No. Sch 40

5. Type and color of material	From	To
top soil	0	3
clay	3	19
Sand of clay & loose Rock	19	33
Rock of Blue	33	50
Rock Limestone	50	65
Blue shale	65	96

10. Screen: Manufacturer's name Pumped
Type PVC Dia. 5
Slot/gauze .035 Length 40
Set between 56 ft. and 96 ft.
Gravel pack? Size range of material 1/4 X 1/2
11. Static water level: 60 ft. below land surface Date 4-28-76 mo./day/yr.
12. Pumping level below land surfaces:
____ ft. after ____ hrs. pumping ____ g.p.m.
____ ft. after ____ hrs. pumping ____ g.p.m.
Estimated maximum yield 8 g.p.m.
13. Water sample submitted: ____ mo./day/yr.
Yes No Date ____
14. Well head completion: NA
____ Pitless adapter ____ Inches above grade
15. Well grouted?
With: Neat cement Bentonite Concrete
Depth: From 20 ft. to 8 ft. 400
16. Nearest source of possible contamination: greek
ft. 400 Direction South type Spring
Well disinfected upon completion? Yes No
17. Pump: Not installed
Manufacturer's name ____
Model number ____ HP ____ Volts ____
Length of drop pipe ____ ft. capacity ____ g.p.m.
Type:
 Submersible Turbine
 Jet Reciprocating
 Centrifugal Other

18. Elevation: 1250
Topography: Hill Slope Upland Valley
19. Remarks:

20. Water well contractor's certification:
This well was drilled under my jurisdiction and this report is true to the best of my knowledge and belief.
Strader Drilling Co 237
Business name Blue Rapids License No. ____
Address Harold Strader Date 4-28-76
Signed Harold Strader Authorized representative