USE TYPEWRITER OR BALL POINT PEN-PRESS FIRMLY, PRINT CLEARLY.

WATER WELL RECORD
KSA 82a-1201-1215

Kansas Department of Health and Environment-Division of Environment
(Water well Contractors)
Topeka, Kansas 66620

1. Location of well:	County	Fraction	Section number	Township number	Range number
	Marshall	X SE 1/4 NW 1/4 SW 1/4	18	T 3 S	R 7 E E/W

2. Distance and direction from nearest town or city: 1/2 M West of 3 South Marysville
Street address of well location if in city: West of Blue River

3. Owner of well: Mrs Henry Peeks
R.R. or street: R.R.1
City, state, zip code: Marysville KS 66508

4. Locate with "X" in section below:

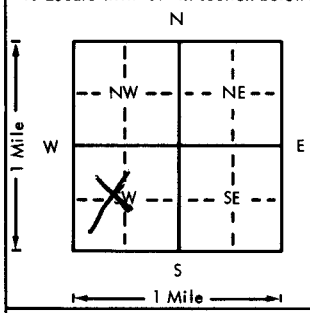

Sketch map:

6. Bore hole dia. 12 in. Completion date
Well depth 50 ft. 6-11-76

7. X Cable tool __ Rotary __ Driven __ Dug
__ Hollow rod __ Jetted __ Bored __ Reverse rotary

8. Use: X Domestic __ Public supply __ Industry
__ Irrigation __ Air conditioning __ Stock
__ Lawn __ Oil field water __ Other

X. Casing: Material Steel
Threaded X Welded
RMP PVC
Dia. 6 in. to 24 ft. depth
Dia. 5 in. to 50 ft. depth
Height: Above or below Surface 15 in.
Weight 24 lbs./ft.
Wall Thickness or gage No. .250 wall

5. Type and color of material

	From	To
Top Soil Black	1	5
Gravel Sandy	5	23
Gravel Rocky	23	25
Blue Shale Soft	25	28
Flint rock Hard & Blue	28	50

(Use a second sheet if needed)

10. Screen: Manufacturer's name Pumpco
Type P.V.C. 258 Dia. 5
Slot/gage .030 Length 20
Set between 30 ft. and 50 ft.
ft. and ft.
Gravel pack? X Size range of material 1/8 XXX

11. Static water level:
30 ft. below land surface Date 6-11-76 mo./day/yr.

12. Pumping level below land surfaces:
ft. after hrs. pumping g.p.m.
ft. after hrs. pumping g.p.m.
Estimated maximum yield 30 g.p.m.

13. Water sample submitted: mo./day/yr.
Yes X No Date

14. Well head completion: N A
Pitless adapter Inches above grade

15. Well grouted? X 1-2
With: Neat cement Bentonite X Concrete
Depth: From 15 ft. to 4 ft.

16. Nearest source of possible contamination:
ft. 500 Direction S W Type Barn
Well disinfected upon completion? X Yes No

17. Pump: X Not installed
Manufacturer's name
Model number HP Volts
Length of drop pipe ft. capacity g.p.m.
Type:
Submersible Turbine
Jet Reciprocating
Centrifugal Other

18. Elevation:

Topography:
Hill
X Slope
Upland
Valley

19. Remarks:

20. Water well contractor's certification:
This well was drilled under my jurisdiction and this report is true to the best of my knowledge and belief.
Business name Strader Drilling Co License No. 237
Address Blue Rapids
Signed Harold Strader Date 6-11
Authorized representative

T 3 R 7 E/W Sec 18 1/4 1/4 1/4 SE NW SW

Forward the white, blue and pink copies to the Department of Health and Environment

Form WWC-5