


1 LOCATION OF WATER WELL: County: Marshall Fraction: SE 1/4 SE 1/4 SW 1/4 Section Number: 12 Township Number: T 3 S Range Number: R 7 EW

Distance and direction from nearest town or city street address of well if located within city?
Approximately 2 1/2 miles south and 3 miles east of Marysville, KS

2 WATER WELL OWNER: Marysville, City of
 RR#, St. Address, Box #: City Hall - 209 N. 8th Board of Agriculture, Division of Water Resources
 City, State, ZIP Code: Marysville, Ks 66508 Application Number: Not Available

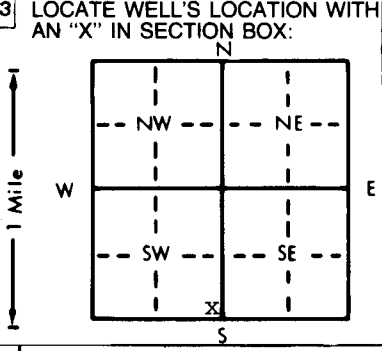

4 DEPTH OF COMPLETED WELL: 116 ft. ELEVATION: unknown
 Depth(s) Groundwater Encountered: 1. 93 ft. 2. _____ ft. 3. _____ ft.
 WELL'S STATIC WATER LEVEL: 39 ft. below land surface measured on mo/day/yr _____
 Pump test data: Well water was not ch'd ft. after _____ hours pumping _____ gpm
 Est. Yield unknown gpm: Well water was _____ ft. after _____ hours pumping _____ gpm
 Bore Hole Diameter: 5 in. to 116 ft., and _____ in. to _____ ft.
 WELL WATER TO BE USED AS:
 5 Public water supply 8 Air conditioning 11 Injection well
 1 Domestic 3 Feedlot 6 Oil field water supply 9 Dewatering 12 Other (Specify below)
 2 Irrigation 4 Industrial 7 Lawn and garden only 10 Monitoring well Perm Observation Well
 Was a chemical/bacteriological sample submitted to Department? Yes X No _____; If yes, mo/day/yr sample was submitted _____
 Water Well Disinfected? Yes _____ No X

5 TYPE OF BLANK CASING USED:
 1 Steel 3 RMP (SR) 5 Wrought iron 8 Concrete tile CASING JOINTS: Glued X Clamped _____
 2 PVC 4 ABS 6 Asbestos-Cement 9 Other (specify below) Welded _____
 7 Fiberglass _____ Threaded _____
 Blank casing diameter: 2 in. to 93 ft., Dia _____ in. to _____ ft., Dia _____ in. to _____ ft.
 Casing height above land surface: 24 in., weight 44 lbs./ft. Wall thickness or gauge No. 091
 TYPE OF SCREEN OR PERFORATION MATERIAL:
 1 Steel 3 Stainless steel 5 Fiberglass 7 PVC 10 Asbestos-cement
 2 Brass 4 Galvanized steel 6 Concrete tile 8 RMP (SR) 11 Other (specify) _____
 9 ABS 12 None used (open hole)
 SCREEN OR PERFORATION OPENINGS ARE:
 1 Continuous slot 3 Mill slot 5 Gauzed wrapped 8 Saw cut 11 None (open hole)
 2 Louvered shutter 4 Key punched 6 Wire wrapped 9 Drilled holes
 7 Torch cut 10 Other (specify) _____
 SCREEN-PERFORATED INTERVALS: From 93 ft. to 113 ft., From _____ ft. to _____ ft.
 From _____ ft. to _____ ft., From _____ ft. to _____ ft.
 GRAVEL PACK INTERVALS: From 73 ft. to 113 ft., From _____ ft. to _____ ft.
 From 20 ft. to 69 ft., From _____ ft. to _____ ft.

6 GROUT MATERIAL: 1 Neat cement 2 Cement grout 3 Bentonite 4 Other Bentonite hole plug
 Grout Intervals: From _____ ft. to _____ ft., From 0 ft. to 20 ft., From 69 ft. to 73 ft.
 What is the nearest source of possible contamination:
 1 Septic tank 4 Lateral lines 7 Pit privy 10 Livestock pens 14 Abandoned water well
 2 Sewer lines 5 Cess pool 8 Sewage lagoon 11 Fuel storage 15 Oil well/Gas well
 3 Watertight sewer lines 6 Seepage pit 9 Feedyard 12 Fertilizer storage 16 Other (specify below) none known
 13 Insecticide storage _____
 Direction from well? _____ How many feet? _____

FROM	TO	LITHOLOGIC LOG	FROM	TO	PLUGGING INTERVALS
0	4	Topsoil			Lithologic Log Continued
4	15	Clay, brown	113	116	Limestone and shale, gray
15	20	Clay, brown, sandy			
20	40	Sand and gravel, very fine and fine sand			
40	50	Sand and gravel, fine to very fine some medium, some silt 35-40			
50	95	Sand and gravel, very fine and fine sand			
95	96	Cemented sand, hard and clay, white			
96	101	Sand and gravel, very fine and fine sand			
101	102	Cemented sand, hard			
102	113	Sand and gravel, very fine and fine sand			

7 CONTRACTOR'S OR LANDOWNER'S CERTIFICATION: This water well was (1) constructed, (2) reconstructed, or (3) plugged under my jurisdiction and was completed on (mo/day/year) 9-20-89 and this record is true to the best of my knowledge and belief. Kansas Water Well Contractor's License No. 185 This Water Well Record was completed on (mo/day/yr) 9-26-89 under the business name of Clarke Well & Equipment, Inc. by (signature) [Signature]