


1 LOCATION OF WATER WELL: Fraction NW 1/4 NE 1/4 Section Number 12 Township Number T 3 S Range Number R 7 **EW**  
 County: Marshall  
 Distance and direction from nearest town or city street address of well if located within city?  
 Approximately 1 1/2 miles south and 3 miles east of Marysville, KS Not Available

2 WATER WELL OWNER: Marysville, City of  
 RR#, St. Address, Box #: City Hall - 209 N. 8th Board of Agriculture, Division of Water Resources  
 City, State, ZIP Code: Marysville, KS 66508 Application Number:

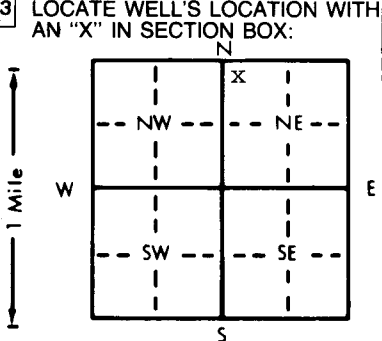

4 DEPTH OF COMPLETED WELL: 105 ft. ELEVATION: unknown  
 Depth(s) Groundwater Encountered 1. ft. 2. ft. 3. ft.  
 WELL'S STATIC WATER LEVEL: 39 ft. below land surface measured on mo/day/yr  
 Pump test data: Well water was not ch'dt. after hours pumping gpm  
 Est. Yield unknown gpm: Well water was ft. after hours pumping gpm  
 Bore Hole Diameter: 4.4 in. to 10.5 ft., and in. to ft.  
 WELL WATER TO BE USED AS:  
 5 Public water supply 8 Air conditioning 11 Injection well  
 1 Domestic 3 Feedlot 6 Oil field water supply 9 Dewatering 12 Other (Specify below)  
 2 Irrigation 4 Industrial 7 Lawn and garden only 10 Monitoring well  
 Was a chemical/bacteriological sample submitted to Department? Yes  No ; If yes, mo/day/yr sample was submitted  
 Water Well Disinfected? Yes  No

5 TYPE OF BLANK CASING USED:  
 1 Steel 3 RMP (SR) 5 Wrought iron 8 Concrete tile CASING JOINTS: Glued Clamped  
 2 PVC 4 ABS 6 Asbestos-Cement 9 Other (specify below) Welded   
 7 Fiberglass Threaded  
 Blank casing diameter: 12.3/4 in. to 6.9 ft., Dia. in. to ft., Dia. in. to ft.  
 Casing height above land surface: 18 in., weight 49.56 lbs./ft. Wall thickness or gauge No. 375  
 TYPE OF SCREEN OR PERFORATION MATERIAL:  
 1 Steel 3 Stainless steel 5 Fiberglass 8 RMP (SR) 10 Asbestos-cement 11 Other (specify)  
 2 Brass 4 Galvanized steel 6 Concrete tile 9 ABS 12 None used (open hole)  
 SCREEN OR PERFORATION OPENINGS ARE:  
 1 Continuous slot 0.35 3 Mill slot 5 Gauzed wrapped 8 Saw cut 11 None (open hole)  
 2 Louvered shutter 4 Key punched 6 Wire wrapped 9 Drilled holes  
 7 Torch cut 10 Other (specify)  
 SCREEN-PERFORATED INTERVALS: From 6.9 ft. to 10.4 ft., From ft. to ft.  
 From ft. to ft., From ft. to ft.  
 GRAVEL PACK INTERVALS: From 3.7 ft. to 10.4 ft., From ft. to ft.  
 From ft. to ft., From ft. to ft.

6 GROUT MATERIAL: 1 Neat cement 2 Cement grout 3 Bentonite 4 Other Fine sand and Bentonite hole pl  
 Grout Intervals: From 5 ft. to 20 ft., From ft. to ft., From 20 ft. to 37 ft.  
 What is the nearest source of possible contamination:  
 1 Septic tank 4 Lateral lines 7 Pit privy 10 Livestock pens 14 Abandoned water well  
 2 Sewer lines 5 Cess pool 8 Sewage lagoon 11 Fuel storage 15 Oil well/Gas well  
 3 Watertight sewer lines 6 Seepage pit 9 Feedyard 12 Fertilizer storage 16 Other (specify below)  
 13 Insecticide storage none known  
 Direction from well? How many feet?

FROM	TO	LITHOLOGIC LOG	FROM	TO	PLUGGING INTERVALS
0	5	Topsoil			
5	17	Clay, brown			
17	20	Sand and Clay, brown, sandy			
20	40	Sand and gravel, very fine and fine sand			
40	40.5	Clay, white			
40.5	46	Streaks of clay, brown, sandy and streaks of sand			
46	104	Sand and Gravel, very fine and fine sand			
104	105	Rocks and Gravel			

7 CONTRACTOR'S OR LANDOWNER'S CERTIFICATION: This water well was (1) constructed, (2) reconstructed, or (3) plugged under my jurisdiction and was completed on (mo/day/year) 9-22-89 and this record is true to the best of my knowledge and belief. Kansas Water Well Contractor's License No. 185 This Water Well Record was completed on (mo/day/yr) 9-26-89 under the business name of Clarke Well & Equipment, Inc. by (signature) *Clarke Well & Equipment, Inc.*