


1 LOCATION OF WATER WELL: County: <u>Marshall</u>	Fraction <u>NW 1/4 NW 1/4 NE 1/4</u>	Section Number <u>12</u>	Township Number <u>T 3 S</u>	Range Number <u>R 7</u> <b>EW</b>
--	---	-----------------------------	---------------------------------	--------------------------------------

Distance and direction from nearest town or city street address of well if located within city?

Approximately 1 1/2 miles south and 3 miles east of Marysville, KS

2 WATER WELL OWNER: RR#, St. Address, Box # : City, State, ZIP Code :	<u>Marysville, City of</u> <u>City Hall - 209 N. 8th</u> <u>Marysville, KS 66508</u>	Board of Agriculture, Division of Water Resources Application Number:
---	--	--

3 LOCATE WELL'S LOCATION WITH AN "X" IN SECTION BOX:

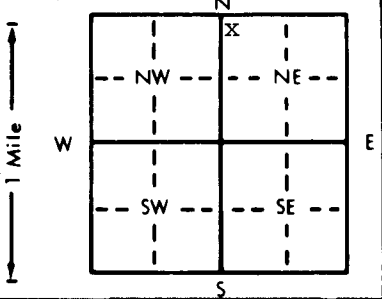

4 DEPTH OF COMPLETED WELL: <u>104</u> ft. ELEVATION: <u>unknown</u>
Depth(s) Groundwater Encountered 1. <u>65</u> ft. 2. _____ ft. 3. _____ ft.
WELL'S STATIC WATER LEVEL <u>39</u> ft. below land surface measured on mo/day/yr _____
Pump test data: Well water was <u>not ch'd</u> ft. after _____ hours pumping _____ gpm
Est. Yield <u>unknown</u> gpm: Well water was _____ ft. after _____ hours pumping _____ gpm
Bore Hole Diameter <u>9</u> in. to <u>104</u> ft., and _____ in. to _____ ft.
WELL WATER TO BE USED AS:
5 Public water supply 8 Air conditioning 11 Injection well
1 Domestic 3 Feedlot 6 Oil field water supply 9 Dewatering 12 Other (Specify below)
2 Irrigation 4 Industrial 7 Lawn and garden only <b>10</b> Monitoring well <u>Supply Well</u> Permanent observation
Was a chemical/bacteriological sample submitted to Department? Yes <u>X</u> No _____; If yes, mo/day/yr sample was submitted _____
Water Well Disinfected? Yes <u>X</u> No _____

5 TYPE OF BLANK CASING USED:	5 Wrought iron	8 Concrete tile	CASING JOINTS: Glued <u>X</u> Clamped _____
1 Steel	3 RMP (SR)	6 Asbestos-Cement	9 Other (specify below)
2 <u>PVC</u>	4 ABS	7 Fiberglass	Welded _____
Blank casing diameter <u>5</u> in. to <u>61</u> ft., Dia _____ in. to _____ ft., Dia _____ in. to _____ ft.			Threaded _____
Casing height above land surface <u>24</u> in., weight <u>2.36</u> lbs./ft. Wall thickness or gauge No. <u>214</u>			
TYPE OF SCREEN OR PERFORATION MATERIAL:		7 <u>PVC</u>	10 Asbestos-cement
1 Steel	3 Stainless steel	5 Fiberglass	8 RMP (SR)
2 Brass	4 Galvanized steel	6 Concrete tile	9 ABS
SCREEN OR PERFORATION OPENINGS ARE:		8 Saw cut	11 None (open hole)
1 Continuous slot	3 Mill slot	6 Wire wrapped	9 Drilled holes
2 Louvered shutter	4 Key punched	7 Torch cut	10 Other (specify) _____
SCREEN-PERFORATED INTERVALS:	From <u>61</u> ft. to <u>96</u> ft., From _____ ft. to _____ ft.		
GRAVEL PACK INTERVALS:	From <u>53</u> ft. to <u>96</u> ft., From _____ ft. to _____ ft.		
	From <u>25</u> ft. to <u>49</u> ft., From _____ ft. to _____ ft.		

6 GROUT MATERIAL:	1 Neat cement	2 Cement grout	3 Bentonite	4 Other <u>Bentonite hole plug</u>
Grout Intervals: From _____ ft. to _____ ft., From <u>0</u> ft. to <u>25</u> ft., From <u>49</u> ft. to <u>53</u> ft.				
What is the nearest source of possible contamination:			10 Livestock pens	14 Abandoned water well
1 Septic tank	4 Lateral lines	7 Pit privy	11 Fuel storage	15 Oil well/Gas well
2 Sewer lines	5 Cess pool	8 Sewage lagoon	12 Fertilizer storage	16 Other (specify below)
3 Watertight sewer lines	6 Seepage pit	9 Feedyard	13 Insecticide storage	<u>none known</u>

Direction from well?		How many feet?			
FROM	TO	LITHOLOGIC LOG	FROM	TO	PLUGGING INTERVALS
0	5	Topsoil			
5	16	Clay, brown			
16	21	Clay, brown, sandy			
21	46	Sand and Gravel, very fine and fine sand			
46	50	Streaks of clay, brown, sandy and streaks of sand			
50	104	Sand and Gravel, very fine and fine sand with clay streak at 88'			
104		Limestone			

7 CONTRACTOR'S OR LANDOWNER'S CERTIFICATION: This water well was (1) constructed, (2) reconstructed, or (3) plugged under my jurisdiction and was completed on (mo/day/year) <u>9-18-89</u> and this record is true to the best of my knowledge and belief. Kansas Water Well Contractor's License No. <u>185</u> . This Water Well Record was completed on (mo/day/yr) <u>9-25-89</u> under the business name of <u>Clarke Well &amp; Equipment, Inc.</u> by (signature) <u>David W. Clarke</u>
--