


1 LOCATION OF WATER WELL: County: Marshall Fraction SW 1/4 SW 1/4 NE 1/4 Section Number 18 Township Number T 3 S Range Number R 7 E

Distance and direction from nearest town or city street address of well if located within city?
Marysville west of River, then on Farm Road South 3 1/2 miles
 2 WATER WELL OWNER: Robert Peck no improvements there
 RR#, St. Address, Box #: R 2 Board of Agriculture, Division of Water Resources
 City, State, ZIP Code: Marysville Kans 66508 Application Number:

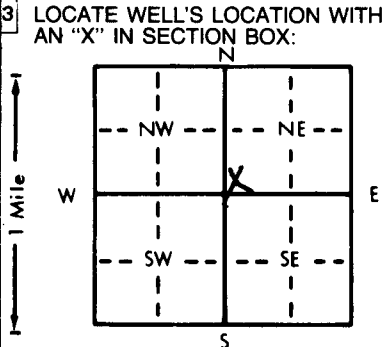

4 DEPTH OF COMPLETED WELL: 50 ft. ELEVATION: ft.
 Depth(s) Groundwater Encountered 29 to 36 ft. 2. ft. 3. ft.
 WELL'S STATIC WATER LEVEL 23 ft. below land surface measured on mo/day/yr Oct 29 - 1981
 Pump test data: Well water was ft. after hours pumping gpm
 Est. Yield 25 gpm; Well water was ft. after hours pumping gpm
 Bore Hole Diameter 11 in. to 16 in., and 8 in. to 3.6 in.
 WELL WATER TO BE USED AS: 5 Public water supply 8 Air conditioning 11 Injection well
1 Domestic 3 Feedlot 6 Oil field water supply 9 Dewatering 12 Other (Specify below)
 2 Irrigation 4 Industrial 7 Lawn and garden only 10 Observation well
 Was a chemical/bacteriological sample submitted to Department? Yes.....No X.....; If yes, mo/day/yr sample was submitted
 Water Well Disinfected? Yes X No

5 TYPE OF BLANK CASING USED: 5 Wrought iron 8 Concrete tile CASING JOINTS: Glued X Clamped
1 Steel 3 RMP (SR) 6 Asbestos-Cement 9 Other (specify below) Welded
 2 PVC 4 ABS 7 Fiberglass Blank casing is torch Threaded
 Blank casing diameter 7 in. to 3.6 in. Dia Perforated 3.6 ft to 30 ft in. to ft.
 Casing height above land surface 12 in., weight 231 lbs./ft. Wall thickness or gauge No. 231 Wall
 TYPE OF SCREEN OR PERFORATION MATERIAL: 7 PVC 10 Asbestos-cement
 1 Steel 3 Stainless steel 5 Fiberglass 8 RMP (SR) 11 Other (specify)
 2 Brass 4 Galvanized steel 6 Concrete tile 9 ABS 12 None used (open hole)
 SCREEN OR PERFORATION OPENINGS ARE: 5 Gauzed wrapped 8 Saw cut 11 None (open hole)
 1 Continuous slot 3 Mill slot 6 Wire wrapped 9 Drilled holes
 2 Louvered shutter 4 Key punched 7 Torch cut 10 Other (specify)
 SCREEN-PERFORATED INTERVALS: From 30 ft. to 30 ft., From ft. to ft.
 From ft. to ft., From ft. to ft.
 GRAVEL PACK INTERVALS: From 36 ft. to 16 ft., From ft. to ft.
 From ft. to ft., From ft. to ft.

6 GROUT MATERIAL: 1 Neat cement 2 Cement grout 3 Bentonite 4 Other
 Grout Intervals: From 16 ft. to 6 ft., From ft. to ft., From ft. to ft.
 What is the nearest source of possible contamination: 10 Livestock pens 14 Abandoned water well
 1 Septic tank 4 Lateral lines 7 Pit privy 11 Fuel storage 15 Oil well/Gas well
 2 Sewer lines 5 Cess pool 8 Sewage lagoon 12 Fertilizer storage 16 Other (specify below)
 3 Watertight sewer lines 6 Seepage pit 9 Feedyard 13 Insecticide storage Creek
 Direction from well? 200 feet South How many feet?

FROM	TO	LITHOLOGIC LOG	FROM	TO	LITHOLOGIC LOG
0	15	top Soil, Black			
15	29	clay, joint yellow			
29	36	gravel + sand, yellow <u>water</u>			
36	50	Shale, Blue Hard			

7 CONTRACTOR'S OR LANDOWNER'S CERTIFICATION: This water well was (1) constructed (2) reconstructed, or (3) plugged under my jurisdiction and was completed on (mo/day/year) Oct. 29 - 1981 and this record is true to the best of my knowledge and belief. Kansas Water Well Contractor's License No. 237 This Water Well Record was completed on (mo/day/yr) Nov. 2 - 1981 under the business name of Strader Drilling Co. by (signature) Harold Strader

INSTRUCTIONS: Use typewriter or ball point pen, PLEASE PRESS FIRMLY and PRINT clearly. Please fill in blanks, underline or circle the correct answers. Send top three copies to Kansas Department of Health and Environment, Division of Environment, Environmental Geology Section, Topeka, KS 66620. Send one to WATER WELL OWNER and retain one for your records.