


USE TYPEWRITER OR BALL POINT PEN-PRESS FIRMLY, PRINT CLEARLY.

WATER WELL RECORD
KSA 82a-1201-1215

Kansas Department of Health and Environment-Division of Environment
(Water well Contractors)
Topeka, Kansas 66620

1. Location of well: County Marshall Fraction SW 1/4 NW 1/4 NW 1/4 Section number 3 Township number T 3 S Range number R 8 E NW

2. Distance and direction from nearest town or city: 1 1/2 mi south of Home, Kans.
Street address of well location if in city:
3. Owner of well: Richard J. Gothier
R.R. or street: 1
City, state, zip code: Home Kans. 66438

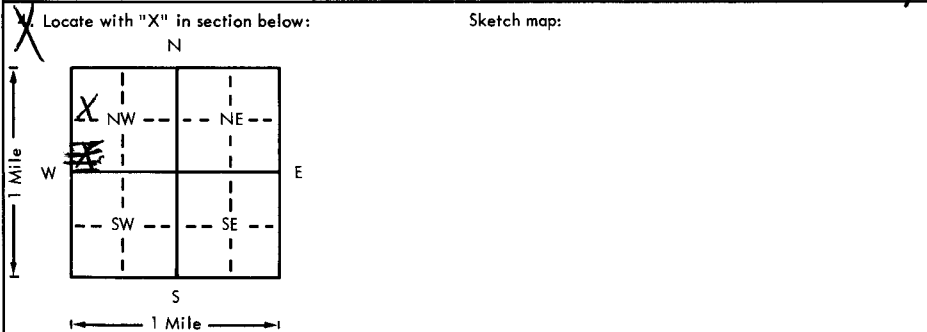

| 5. Type and color of material | From | To |
|--------------------------------|------|----|
| Clay Brown | 0 | 10 |
| Lime Rock White | 10 | 12 |
| Clay yellow | 12 | 20 |
| " Brown with Gravel | 20 | 25 |
| " yellow | 25 | 40 |
| Lime Rock White | 40 | 47 |
| Shale Gray | 47 | 55 |
| " Brown | 55 | 60 |
| (Use a second sheet if needed) | | |

6. Bore hole dia. 8 in. Completion date 4-21-78
Well depth 60 ft.

7. Cable tool Rotary Driven Dug
 Hollow rod Jetted Bored Reverse rotary

8. Use: Domestic Public supply Industry
 Irrigation Air conditioning Stock
 Lawn Oil field water Other

9. Casing: Material PLST. Height: Above below
Threaded Welded ALUC Surface 20 in.
RMP PVC Weight lbs./ft.
Dia. 5 in. to 60 ft. depth; Wall Thickness: inches or
Dia. in. to ft. depth; gage No. Sch 40

10. Screen: Manufacturer's name Slot By Driller
Type PRC Dia. 5"
Slot/gauze 7/16 Length 20'
Set between 40 ft. and 60 ft.
 ft. and ft.
Gravel pack? Yes Size range of material 1/8-1/2

11. Static water level: 37 ft. below land surface mo./day/yr. Date 4-21-78

12. Pumping level below land surfaces:
 ft. after hrs. pumping g.p.m.
 ft. after hrs. pumping g.p.m.
Estimated maximum yield g.p.m.

13. Water sample submitted: mo./day/yr.
 Yes No Date

14. Well head completion:
 Pitless adapter inches above grade

Well grouted? yes
With: Neat cement Bentonite Concrete
Depth: From 4 ft. to 14 ft.

16. Nearest source of possible contamination: 100' ft. Direction ck Type Septic Tank
Well disinfected upon completion? Yes No

17. Pump: Not installed
Manufacturer's name
Model number HP Volts
Length of drop pipe ft. capacity g.p.m.
Type:
 Submersible Turbine
 Jet Reciprocating
 Centrifugal Other

18. Elevation:
Topography:
 Hill
 Slope
 Upland
 Valley

19. Remarks: Cement slab to be poured by land owner 4x4x4" thick

20. Water well contractor's certification:
This well was drilled under my jurisdiction and this report is true to the best of my knowledge and belief.
Harpers Drlg. Serv. 176
Business name Blue Rapids, KS License No.
Address
Signature E. Harpers Date 4-21-78
Authorized representative

T 3
R 8 E
S 3
SW 1/4 NW 1/4 NW 1/4