

USE TYPEWRITER OR BALL POINT PEN-PRESS FIRMLY, PRINT CLEARLY.

WATER WELL RECORD  
KSA 82a-1201-1215


T R EW sec 1/4 1/4 1/4 No.

Kansas State Dept. Of Health  
(Water Well Contractors)  
Forbes-Bldg. 740  
Topeka, Kansas 66620

*NW SW NW*

1 Location of well: County Marshall Township name Center Fraction W 1/2 NW 1/4 Section number 32 Town number 3 Range number 8 E

Distance and direction from nearest town or city: \_\_\_\_\_ 3 Owner of well: Joe O'Tool  
Street address of well location if in city: \_\_\_\_\_ Address: Marysville Kans. RT 3

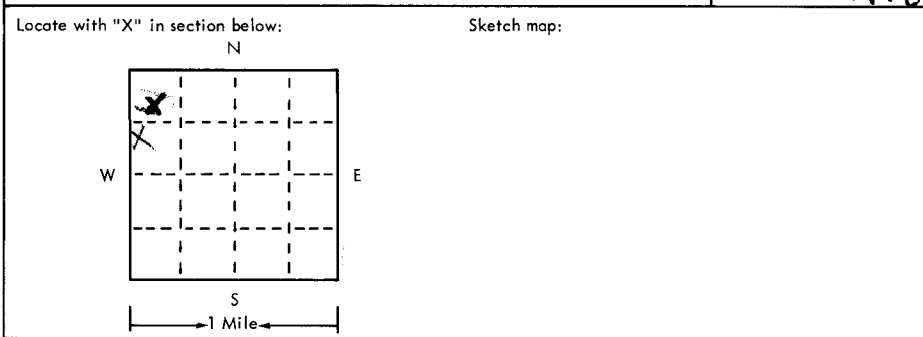

4 Well depth: 110 ft. Date of completion June 5-75  
Well diameter 5" in.

5  Cable tool  Rotary  Driven  Dug  
 Hollow rod  Jetted  Bored  Reverse rotary

6 Use:  Domestic  Public supply  Industry  
 Irrigation  Air conditioning  Commercial  
 Test well  House water

7 Casing: Material PVC Height: above/below  
Threaded  Welded  Surface 24 in.  
Diam. Cement Weight \_\_\_\_\_ lbs./ft. \_\_\_\_\_  
5 in. to 110 ft. depth Drive shoe?  Yes  No  
\_\_\_\_\_ in. to \_\_\_\_\_ ft. depth

2	Type and color of material	From	To
	<u>Top Soil Brown Clay - Glacier Rocks - Graint</u>	<u>0</u>	<u>10</u>
	<u>Lime Rock &amp; Brown Shale</u>	<u>10</u>	<u>25</u>
	<u>Gray Clay &amp; Flint</u>	<u>25</u>	<u>30</u>
	<u>Lime Rock &amp; Brown Shale</u>	<u>30</u>	<u>37</u>
	<u>Lime Rock &amp; Brown Shale</u>	<u>37</u>	<u>41</u>
	<u>Brown Shale &amp; Brown Clay</u>	<u>41</u>	<u>51</u>
	<u>Brown Clay &amp; Blue Clay</u>	<u>51</u>	<u>56</u>
	<u>Blue Clay &amp; Lime Rock 1<sup>st</sup> water</u>	<u>56</u>	<u>61</u>
	<u>Lime Rock &amp; Blue Soap Stone</u>	<u>61</u>	<u>66</u>
	<u>Lime Rock &amp; Blue Shale dry hole now</u>	<u>66</u>	<u>71</u>
	<u>Lime Rock &amp; Blue Shale</u>	<u>71</u>	<u>76</u>
	<u>Brown Shale</u>	<u>76</u>	<u>81</u>
	<u>Brown Clay some fine sand 2<sup>nd</sup> water</u>	<u>81</u>	<u>86</u>
	<u>Blue Shale &amp; Blue Flint Rock</u>	<u>86</u>	<u>110</u>

8 Screen: Manufacturer Homade  
Type PVC Dia. \_\_\_\_\_  
Slot/gauze 20 Length 20  
Set between 40 ft. and 110 ft.  
Fittings: \_\_\_\_\_  
Gravel pack  Yes  No Size range of material NO

9 Static water level: 56 ft. below land surface Date \_\_\_\_\_

10 Pumping level below land surfaces:  
\_\_\_\_\_ ft. after \_\_\_\_\_ hrs. pumping \_\_\_\_\_ g.p.m.  
\_\_\_\_\_ ft. after N.A. hrs. pumping \_\_\_\_\_ g.p.m.  
Estimated maximum yield \_\_\_\_\_ g.p.m.

11 Water sample submitted:  
 Yes  No Date \_\_\_\_\_

12 Well head completion:  
 Pitless adapter  Inches above grade

13 Well grouted?  Yes  No  
 Neat cement  Bentonite \_\_\_\_\_  
Depth: From 4 ft. to 14 ft.

14 Nearest source of possible contamination:  
ft. 200 Direction S.E. Type House  
Well disinfected upon completion?  Yes  No

15 Pump:  Not installed  
Manufacturer's name \_\_\_\_\_  
Model number \_\_\_\_\_ HP \_\_\_\_\_ Volts \_\_\_\_\_  
Length of drop pipe \_\_\_\_\_ ft. capacity \_\_\_\_\_ g.m.p.  
Type:  
 Submersible  Turbine  
 Jet  Reciprocating  
 Centrifugal  Other

16 Remarks: elevation 1395

Topography:  
 Hill  
 Slope  
 Upland  
 Valley

17 Water well contractor's certification:  
This well was drilled under my jurisdiction and this report is true to the best of my knowledge and belief.  
Harpers Drilling Service  
Business name \_\_\_\_\_ License No. \_\_\_\_\_  
Address: Blue Rapids KS 67026  
Signed: [Signature] Date 6-5-75  
Authorized representative