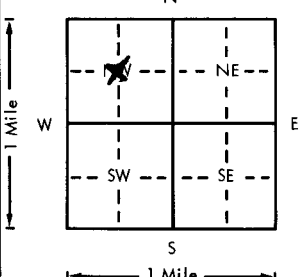


USE TYPEWRITER OR BALL
POINT PEN-PRESS FIRMLY,
PRINT CLEARLY.

WATER WELL RECORD
KSA 82a-1201-1215

Kansas Department of Health and
Environment-Division of Environment
(Water well Contractors)
Topeka, Kansas 66620

1. Location of well:		County Marshall	Fraction 1/4 Ctr. of NW 1/4	Section number 30	Township number T 3 S R 9 E/W	Range number 9
2. Distance and direction from nearest town or city: Frankfort, Ks. on 99 & 3 mi. West on Winifred Rd.			3. Owner of well: Harry Wullschlegler R.R. or street: City, state, zip code: Winifred, Kansas			
4. Locate with "X" in section below:		Sketch map:		6. Bore hole dia. 30 in. Completion date 5-6-77 Well depth 47 ft.		
				7. Cable tool <input type="checkbox"/> Rotary <input type="checkbox"/> Driven <input type="checkbox"/> Dug <input type="checkbox"/> Hollow rod <input type="checkbox"/> Jetted <input type="checkbox"/> Bored <input checked="" type="checkbox"/> Reverse rotary		
5. Type and color of material		From To		8. Use: Domestic <input type="checkbox"/> Public supply <input type="checkbox"/> Industry <input type="checkbox"/> <input checked="" type="checkbox"/> Irrigation <input type="checkbox"/> Air conditioning <input type="checkbox"/> Stock <input type="checkbox"/> Lawn <input type="checkbox"/> Oil field water <input type="checkbox"/> Other <input type="checkbox"/>		
Hard black gumbo		0 12		9. Casing: Material Trans Height: (Above) or below Threaded <input type="checkbox"/> Welded <input type="checkbox"/> Surface 12 in. RMP <input type="checkbox"/> PVC <input type="checkbox"/> Weight <input type="checkbox"/> lbs./ft. Dia. 16 in. to 21 ft. depth Wall Thickness: inches or Dia. <input type="checkbox"/> in. to <input type="checkbox"/> ft. depth gage No. 7/8		
Hard gray clay		12 30		10. Screen: Manufacturer's name Johnson Type Transite Dia. 16" (Slo) gauze 1/8x8 Length 26' Set between 21 ft. and 47 ft. Gravel pack? yes Size range of material 5/8		
Lt. gray clay		30 31		11. Static water level: <input type="checkbox"/> mo./day/yr. 10 ft. below land surface Date 5-6-77		
Med. to large limestone gravel & gray clay		31 32		12. Pumping level below land surfaces: 30 ft. after 1 hrs. pumping 400 g.p.m. 40 ft. after 3 hrs. pumping 500 g.p.m. Estimated maximum yield 600 g.p.m.		
Large to very large limestone gravel		32 46		13. Water sample submitted: <input type="checkbox"/> mo./day/yr. Yes <input checked="" type="checkbox"/> No <input type="checkbox"/> Date <input type="checkbox"/>		
Fine green sugar sand		46 47		14. Well head completion: Pitless adapter <input type="checkbox"/> Inches above grade <input type="checkbox"/>		
Stopped		47		15. Well grouted? yes With: Neat cement <input type="checkbox"/> Bentonite <input checked="" type="checkbox"/> Concrete <input type="checkbox"/> Depth: From 0 ft. to 10 ft.		
BR 92-94				16. Nearest source of possible contamination: ft. 115 Direction NW Type creek Well disinfected upon completion? Yes <input type="checkbox"/> No <input checked="" type="checkbox"/>		
had 20 lb sack shaker bit				17. Pump: <input checked="" type="checkbox"/> Not installed Manufacturer's name <input type="checkbox"/> Model number <input type="checkbox"/> HP <input type="checkbox"/> Volts <input type="checkbox"/> Length of drop pipe <input type="checkbox"/> ft. capacity <input type="checkbox"/> g.p.m. Type: <input type="checkbox"/> Submersible <input type="checkbox"/> Turbine <input type="checkbox"/> Jet <input type="checkbox"/> Reciprocating <input type="checkbox"/> Centrifugal <input type="checkbox"/> Other		
18. Elevation: 1171		19. Remarks: We do not install pumps.		20. Water well contractor's certification: This well was drilled under my jurisdiction and this report is true to the best of my knowledge and belief. Hoobler Drilling Co. 323 Business name License No. Address St. Marys, Ks. 66536 Signed Ken Hoobler Date 5-16-77 Authorized representative		