

F 1 20

✓ CP

USE TYPEWRITER OR BALL POINT PEN-PRESS FIRMLY, PRINT CLEARLY.


WATER WELL RECORD  
KSA 82a-1201-1215

Kansas Department of Health and Environment-Division of Environment (Water well Contractors) Topeka, Kansas 66620

Center - NW - NE

1. Location of well: County Marshall Fraction NE NE NE Section number 17 Township number 4 Range number 10 EW

2. Distance and direction from nearest town or city: South 3/4 mile west of Vermillion  
3. Owner of well: John Stiner  
R.R. or street: \_\_\_\_\_  
City, state, zip code: Vermillion, Mo 66544

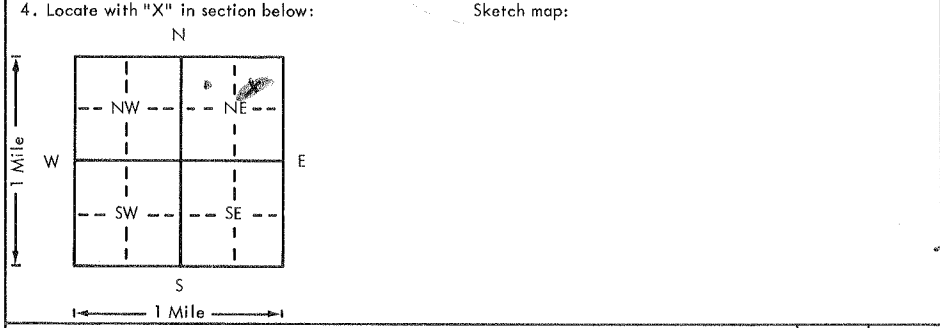

6. Bore hole dia. 8 in. Completion date 3-9-78  
Well depth 185 ft.  
7.  Cable tool  Rotary  Driven  Dug  
 Hollow rod  Jetted  Bored  Reverse rotary  
8. Use:  Domestic  Public supply  Industry  
 Irrigation  Air conditioning  Stock  
 Lawn  Oil field water  Other  
9. Casing: Material Plastic Height: Above or below  
Threaded \_\_\_\_\_ Welded \_\_\_\_\_ Surface 12" in.  
RMP NBF PVC \_\_\_\_\_ Weight 200 lbs./ft.  
Dia. 5" in. to 185 ft. depth Well Thickness: inches or  
Dia. \_\_\_\_\_ in. to \_\_\_\_\_ ft. depth gage No. 200

5. Type and color of material	From	To
Clay Brown	0	10
Sand silty fine	10	20
Silt Brown	20	50
Clay layers silt + iron	50	60
Silt Brown	60	150
Clay Blue + silt	150	166
Rock flint + clay	166	170
Gravel Kans	170	182
Shale Blue	182	185

10. Screen: Manufacturer's name plastic NSF approved  
Type PVC Dia. 5"  
Slot/gauze .030 Length 10'  
Set between 125 ft. and 185 ft.  
Gravel pack?  Size range of material concrete sand  
11. Static water level: \_\_\_\_\_ mo./day/yr.  
53 ft. below land surface Date 3-9-78  
12. Pumping level below land surfaces:  
\_\_\_\_\_ ft. after \_\_\_\_\_ hrs. pumping \_\_\_\_\_ g.p.m.  
\_\_\_\_\_ ft. after \_\_\_\_\_ hrs. pumping \_\_\_\_\_ g.p.m.  
Estimated maximum yield 90 reported g.p.m.  
13. Water sample submitted: \_\_\_\_\_ mo./day/yr.  
Yes  No  Date \_\_\_\_\_  
14. Well head completion: capped  
\_\_\_\_\_ Pitless adapter \_\_\_\_\_ Inches above grade  
15. Well grouted? yes  
With: \_\_\_\_\_ Neat cement \_\_\_\_\_ Bentonite  Concrete  
Depth: From 0 ft. to 20 ft.  
16. Nearest source of possible contamination:  
ft. 600 Direction SE Type Pond  
Well disinfected upon completion?  Yes  No  
17. Pump:  Not installed  
Manufacturer's name \_\_\_\_\_  
Model number \_\_\_\_\_ HP \_\_\_\_\_ Volts \_\_\_\_\_  
Length of drop pipe \_\_\_\_\_ ft. capacity \_\_\_\_\_ g.p.m.  
Type:  
 Submersible  Turbine  
 Jet  Reciprocating  
 Centrifugal  Other

18. Elevation: 1237  
Topography:  
 Hill  
 Slope  
 Upland  
 Valley

19. Remarks:

20. Water well contractor's certification:  
This well was drilled under my jurisdiction and this report is true to the best of my knowledge and belief.  
Blue Valley Drilling 234  
Business name \_\_\_\_\_ License No. \_\_\_\_\_  
Address Blue Rapids, Kansas  
Signed Ronald Strader Date 4-28-78  
Authorized representative

Forward the white, blue and pink copies to the Department of Health and Environment

Form WWC-5

BR = 1055  $\nabla$  = 1184

T 4  
 R 10  
 E  
 W  
 17  
 NE  
 NW  
 SE  
 SW  
 1/4  
 1/4  
 1/4  
 1/4