
	W	ATER WELL RE	CORD Form	WWC-5	(SA 82a-121	2 ID No	sB-07				
1 LOCATION OF	WATER WELL:	Fraction			Section N		Township 1	Number	Range Nu	ımber	
County: Nemah	a	NE 1/4	NE 1/4	ESE 14] 1	L	T XXX	4 s	R 11	E)V	
Distance and direc	tion from nearest	town or city stree	t address of well	if located wi	thin city?					0	
2 WATER WELL	OWNER: HEDA	laga.	· · · · · · · · · · · · · · · · · · ·								
RR#, St. Address,		0513, Rooπ		/00 T-1-		. A	GTT Board of A	griculture, C	Division of Wate	er Resources	
City, State, ZIP Co	u o • tt1_	1 DC	20250 051	2			, .bb				
3 LOCATE WELL'S	LOCATION WITH	4 DEPTH OF	COMPLETED W	ELL. 05/08	7.02ft.	ELEVATI	ON: *X**	1,332	4		
AN "X" IN SECT		Depth(s) Groun	dwater Encounte	ered 1	48	ft. 2.	N/.A	ft. 3.	N/A	ft.	
	<u>N</u>	1	WATER LEVEL								
1 1			np test data: We				-				
_ NW	NE		I/Agpm: We								
			neter4 / 25						in. to55	ft.	
₩ W	I X		TO BE USED A				Air conditioning		njection well		
[1 Domestic	3 Feedlot	6 Oil field	water supp	iy 9 I	Dewatering	0bser	Other (Specify by	pelow) I 1	
	SE	2 Irrigation	4 Industrial	7 Domes	tic (lawn & ga	rden) 10 l	Monitoring well		vacion we		
<u> </u>		I .	bacteriological sar	mple submitted	I to Departme		No _X Vell Disinfected			ple was sub- No X	
5 TYPE OF BLAN	K CASING LISED	mitted	5 Wrought iron	8	Concrete tile				ed Clam		
1 Steel	3 RMP (S		6 Asbestos-Ce		Other (speci				ded	•	
2 PVC	4 ABS	,	7 Fiberglass		` •				aded X		
	neter	l in to	•						••		
	ve land surface]										
1	EN OR PERFORA				70 ∨c	103./10		bestos-cem			
1 Steel	3 Stainles		 5 Fiberglass	,	8 RMP (SR	}					
2 Brass	4 Galvani		6 Concrete tile	` ,			11 Other (specify)				
SCREEN OR PE	REORATION OPE	NINGS ARE:		Gauzed wr	apped		8 Saw cut		11 None (ope	en hole)	
1 Continuous	slot 3	fill slot	(6 Wire wrapped			9 Drilled holes	Drilled holes			
2 Louvered sh		Key punched		7 Torch cut			10 Other (specif				
SCREEN-PERFC	RATED INTERVA						N/A				
CDAVE	L PACK INTERVA		f	t. to	f	t., From .		ft. t	0	ft.	
GHAVE	L PACK INTERVA	From	40 f	t. to	f	t., From .		ft. t	O <u>.</u>	.πAγγ	
6 GROUT MATE	RIAL: 1 Neat		2 Cement grout		Bentonite		her				
	From0		-	_							
	est source of possi			1		Livesto			bandoned wate		
1 Septic tank				it orivo			•		Dil well/Gas well		
1 Septic tank 4 Lateral lines 2 Sewer lines 5 Cess pool				7 Pit privy (8)Sewage lagoon		11 Fuel storage 12 Fertilizer storage		16 Other (specify below)			
3 Watertight sewer lines 6 Seepage pit			_	9 Feedyard			ide storage	10 0	other (specify b	GIOW)	
Direction from we		page pit	31	ccayara		ow many	•	200			
FROM TO		LITHOLOGIC LO	OG.	FR	OM TO				NTERVALS		
0' 2					0			oddii d ii	TENVALO		
2 46											
46' 47											
47½ 48											
48 54				~							
7 CONTRACTOR	S OR LANDOWNE	ER'S CERTIFICAT	FION: This water	well was (1)	constructed,	(2) recon	structed, or (3)	plugged un	der my jurisdicti	ion and was	
7 CONTRACTOR' completed on (mo/	S OR LANDOWNE										
completed on (mo/	day/year) 05. / .1	.0/.02			and thi	s record	is true to the be	st of my kn	owledge and be		
	day/year) 05./.1 ctor's Licence No.	.0 / .02	This Wa	ater Well Rec	and thi	s record pleted on	is true to the be (mo/day/yr) .0	st of my kn	owledge and be		
completed on (mo/ Water Well Contract under the business	day/year) 05./.1 ctor's Licence No.	.0/.02	This Wantal Servi	ater Well Rec	and thi	s record pleted on by (sign	is true to the be (mo/day/yr) .0 ature)	st of my kn 6/.04/0.2	owledge and be	elief. Kansas	

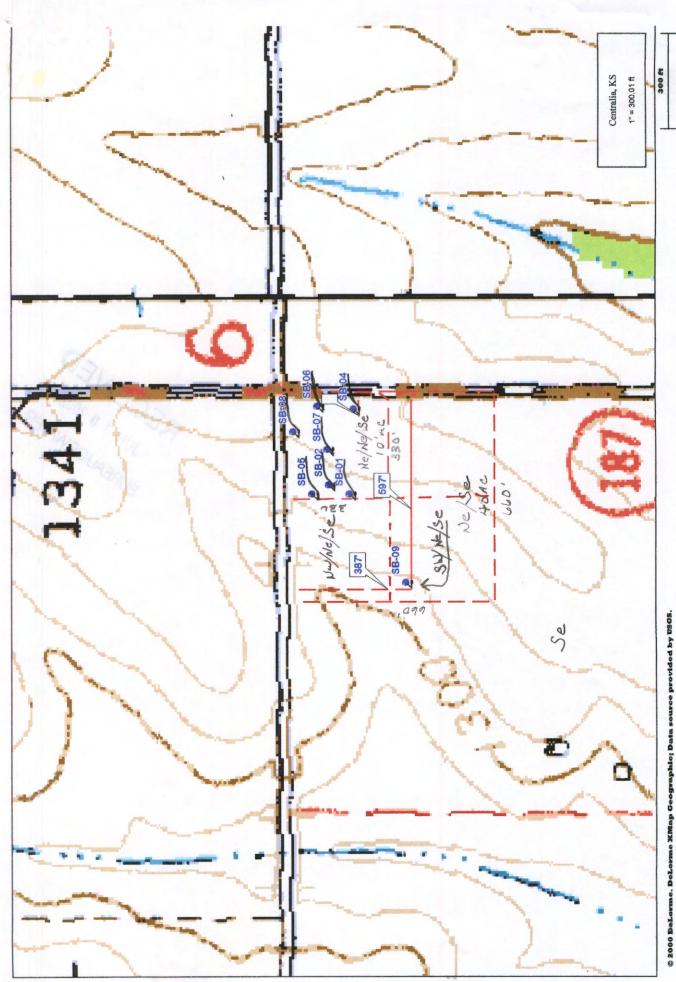

© 2000 DaLorme. DeLorme Mffiap Geographic; Data source provided by USGS. Scale: 1:3,600 Zoom Level: 15-7 Datum: WGS84