
**	W.	ATER WELL RE	CORD Form WWC-	5 KSA 8	2a-1212 ID	No. SB-08			
	WATER WELL:	Fraction			tion Number		umber	Range Nur	nber
County. 74			Ne ¼ Se	1/4	1	т 4	s	R 11	(E) w
		town or city stree	et address of well if loca	ted within ci	ty?				
2 WATER WELL	OWNER : USDA/	CCC							
RR#, St. Address			4717-S/ 1400 1	Independe	ence Ave	SW Board of Agr	riculture, C	Division of Water	Resources
City, State, ZIP C		•	20250-0513			Application N			
3 LOCATE WELL	S LOCATION WITH		COMPLETED WELL						
AN "X" IN SEC			ndwater Encountered						
<u> </u>	<u> </u>		C WATER LEVEL]					•	
			mp test data: Well water						
NW-	NE	F .	N/Agpm: Well wate		•	•			
		Bore Hole Diar	neter 4 . 25 in. t	0	20 ft.,	and 3 25		in. to $.62 \dots$	ft.
<u>₹</u> w ————	 	WELL WATER	TO BE USED AS: 5			8 Air conditioning		njection well	
		1 Domestic	3 Feedlot 6	Oil field wate	r supply	9 Dewatering	0h 02	Other (Specify be	elow)
sw-	SE	2 Irrigation	4 Industrial 7	Domestic (law	n & garden) 1	0 Monitoring well .	opsei	varion wei	.
		Was a chemical	/bacteriological sample su	bmitted to De	partment? Yes	s No	: If ves. n	no/dav/vrs samp	le was sub-
<u> </u>	<u> </u>	mitted	9			r Well Disinfected?	-		lo X
5 TYPE OF BLA	NK CASING USED):	5 Wrought iron	8 Concr				ed Clamp	ed
1 Steel	3 RMP (S	SR)	6 Asbestos-Cement	9 Other	(specify belo	w)	Weld	led	
(2) PVC	4 ABS		7 Fiberglass				Thre	aded. X	
	meter	1in. to	52ft., Dia	N/.A ir	n. to N	/Aft., Dia	. N/.A	in. to N./.	A
			Կո., weight						
			=	(7)₽V			estos-cem		
TYPE OF SCREEN OR PERFORATION MATERIAL: 1 Steel 3 Stainless steel 5 Fiberglass					IP (SR)				
			6 Concrete tile			12 None used (open hole)			
SCREEN OR PERFORATION OPENINGS ARE:			5 Gau	5 Gauzed wrapped		8 Saw cut		11 None (oper	n hole)
1 Continuous	s slot 📆	6 Wire	6 Wire wrapped			9 Drilled notes			
2 Louvered :	shutter 4 l	Key punched		h cut		10 Other (specify			
SCREEN-PERF	ORATED INTERVA	ALS: From	52 ft. to	62	ft., Fron	n	ft. t	oN/A	ft.
0.741	51 BAGK INITED (4	From	50· ft. to	62	ft., Fron	n N.∤.A. -	ft. t	oN/A	ft.
GHAV	EL PACK INTERVA		ft. to						
-1 · · · · · ·	-DIAL 4 No. 1					Other			
6 GROUT MATI			2 Cement grout	•					
			0 ft., From	N / A II	•		•	•	
t	rest source of poss					stock pens		bandoned water	well
1 Septic tank 4 Lateral lines			7 Pit privy		11 Fuel storage			15 Oil well/Gas well	
2 Sewer lines 5 Cess pool			8 Sewage lagoon					6 Other (specify below)	
_	sewer lines 6 See	epage pit	9 Feedya	a		ticide storage			
Direction from w				T =5014			00	ITED (ALC	
FROM TO		LITHOLOGIC L	OG	FROM	ТО	PLU	GGING II	NTERVALS	
	2' Top Soi								
	No Reco								
50 ' 6	2' Medium	to Coarse	Sand	ļ					
					ļ			· · · · · · · · · · · · · · · · · · ·	
					ļ				
7 CONTRACTO	R'S OR LANDQYUN	ER'S CERTIFICA	TION: This water well w	/a/s (1) consti	ructed, (2) red	constructed, or (3) p	lugged un	der my jurisdiction	on and was
completed on (me	o/day/year)	05/10/02			and this reco	rd is true to the bes	t of my kn	owledge and bei	ief. Kansas
Water Well Contr	actor's Licence No.	. 680	This Water W	eli Record wa	as completed	on (mo/day/yr) . 0	61,041,0	ـ ـ ـ	
	actor s Licerice No.								
under the busines				9	by (s	ignature)	(//	′ <′.	
	ss name of Del	ta Environ	nental Service RMLYand <u>PRINT</u> clearly, Please		· · · · · · · · · · · · · · · · · · ·		three copies to	Kansas Bepartment	a Health and

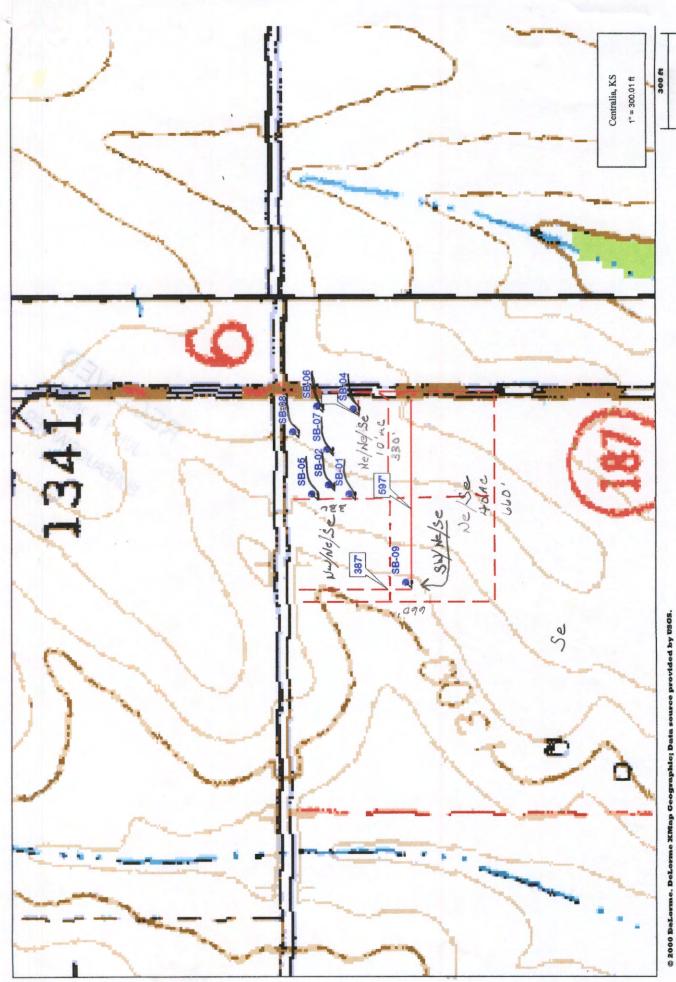

© 2000 DaLorme. DeLorme Mffiap Geographic; Data source provided by USGS. Scale: 1:3,600 Zoom Level: 15-7 Datum: WGS84