
		w	ATER WELL R	ECORD	Form WV	NC-5 K	SA 82a-1	1212 10) No	SB-0	9				
1 LOCATI	ON OF W	ATER WELL:	Fraction	LOOKE							Number	R	Range Number		
 County: I	Nemaha		sw	¼ NE	1/4	SE ¼	1		Т Т	4	s	R	11	E	
Distance a	nd directi	on from nearest			ss of well if		hin city?						11		
2 WATER	WELL O	WNER: USDA,	/ccc		1 - 10		-								
RR#, St. A	ddress, B	ox# : Stop	0513, Roc	om 4717	7-S/ 140	00 Inder	penden	ce Av	e, SW _{Bo}	ard of	Agriculture,	Division	of Wate	r Resources	
City, State,			ington, DC		50-0513						Number:				
3 LOCATE	WELL'S	LOCATION WITH													
AN "X" I	IN SECTI	ON BOX:	Depth(s) Gro												
7 [WELL'S STAT										•		
1	i		P	ump test	data: Well v	water was	N/A	ft.	after	N/A	hours	pumpin	g N./ .A	1 gpm	
	- NW	NE	Est. Yield	N/A	gpm: We!l v	water was .	.N/A	ft.	after	N/A	hours	pumping	g N/ .A	1 gpm	
	1		Bore Hole Dia	ameter A	4 . 2 5 ir	n. to	20	ft.	, and	3.25.		. in. to .	42.	ft.	
₩ W	1	- ' E	WELL WATE	R TO BE	USED AS:	5 Public v	vater sup	ply	8 Air con	ditioning	11 1	njection	well		
Ī	i		1 Domest	-	eedlot	6 Oil field	water su	pply	9 Dewate	ering 	Obser	Other (S	Specify b	elow)	
	- SW	SE	2 Irrigation	n 4 li	ndustrial	7 Domesti	c (lawn &	garden)	10 Monito	ring well	Obser	Vaci)!! WET	: -	
	1		Was a chemic	al/bacterio	ogical sample	e submitted	to Depart	ment? Ye	s	NoX.	: If ves. i	mo/dav/	vrs sam	ole was sub	
<u> </u>	·		mitted								d? Yes			No X	
5 TYPE C	F BLANK	CASING USED	:	5 Wro	ught iron	8 0	Concrete	tile	CA	ASING J	OINTS: Glu	ed	Clamp	ped	
1 Stee		3 RMP (S	SR)	6 Asb	estos-Ceme	nt 9 C	Other (sp	ecify bel	ow)		Wel	ded			
2 PVC		4 ABS		7 Fibe	rglass						Thre	eaded	X		
Blank cas	ing diame	ter	1in. to	32	ft., Dia	N/A	in. to		.N/Af	t., Dia .	N/A	in. i	to N./	'. Α f	
Casing he	eight abov	e land surface	Flush, Mour	1. ti n., weig	jht	3	1,5	lbs	s./ft. Wall t	hicknes	s or gauge I	۷o ا	133		
TYPE OF	SCREEN	OR PERFORA	TION MATERIA	AL:			7 PVC			10 A	sbestos-cen	nent			
1 Steel 3 Stainless steel					5 Fiberglass 8 RMF			SR)		11 01	her (specify	·)		· · · · · · · · · · ·	
2 Brass 4 Galvanized steel					6 Concrete tile 9 ABS			12 /			None used (open hole)				
SCREEN OR PERFORATION OPENINGS ARE:					5 Gauzed wrapped						11 None (open hole)				
	tinuous sl		Aill slot			/ire wrappe	d			led hole				•	
	vered shu	ITTER 4 P	Key punched	32		orch cut	42							ft.	
SCREEN	-PERFOR	IATED INTERVA													
	GRAVEL	PACK INTERVA													
	G		From		ft. to) <i></i>		. ft., Fro	m		ft.	to. ,		ft.	
6 GROUT	MATERI	AL: 1 Neat	cement	2 Cem	ent grout	(3)	Bentonite		1 Other						
		rom				_									
		t source of poss			,				stock per				ned water		
1 Septic tank 4 Lateral lines					7 Pit privy			11 Fuel storage			15 Oil well/Gas well				
2 Sewer lines 5 Cess pool					Bewage lagoon			12 Fertilizer storage			16 Other (specify below)				
3 Watertight sewer lines 6 Seepage pit					9 Feedyard			13 Insecticide storage			Caron (opcomy below)				
Direction	-		F-9- F			-,			any feet?	90	1,200				
FROM	ТО		LITHOLOGIC	LOG		FRO	ОМ	TO	uny 10011	PI	UGGING I	NTFRV	ALS		
01	2'	Top Soi						-							
21	32'	Silty C													
32'	421	Sand	тау												
	42	Janu			<u> </u>										
-															
				· · · · · · · · · · · · · · · · · · ·											
					·										

													<u> </u>		
			•												
7 CONTR	ACTOR'S	OR LANDOWNE	ER'S, CERTIFIC	ATION: TI	nis water we	ell was (1) o	constructe	ed, (2) re	constructe	d, or (3)	plugged ur	nder mv	jurisdiction	on and was	
completed	on (mo/da	05/ ay/year)					and	this reco	ord is true	to the b	est of my kr	nowleda	e and be	lief. Kansas	
-		or's Licence No.	680		. This Water							_			
		ame of Delt							signature)		1.1	7			
		· · · · · · · · · · · · · · · · · · ·								K	well,	-	4		
		pewriter or ball point pe Water, Topeka, Kansas												of Health and	

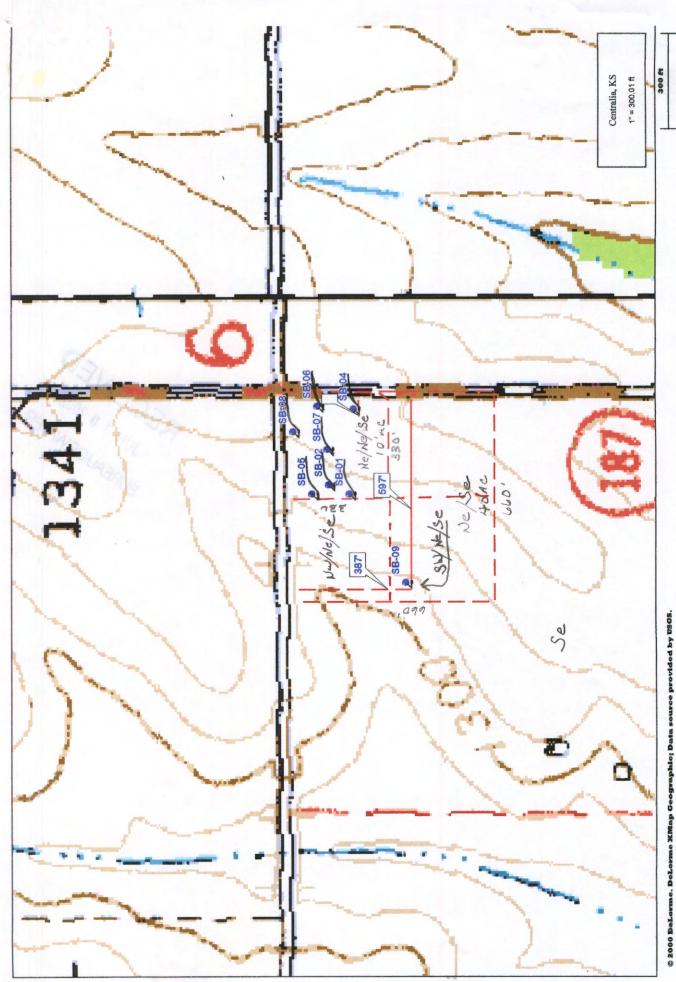

© 2000 DaLorme. DeLorme Mffiap Geographic; Data source provided by USGS. Scale: 1:3,600 Zoom Level: 15-7 Datum: WGS84