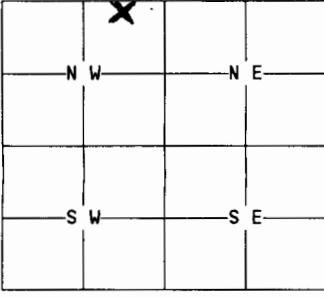


1	LOCATION OF WATER WELL: Name: Nemaha	Fraction NE 1/4 1/4 (1/4)	Section Number 11	Township Number T-4-S	Range Number R-11-E
---	--	--	-----------------------------	---------------------------------	-------------------------------

Distance and direction from nearest town or city street address of well if located within city?
1 1/4 mile West of Centralia Ks. on K-9 Hwy

2	WATER WELL OWNER: KDOT RR#, St. Address, Box #: 801 North 11th St. City, State, ZIP Code : Seneca Ks. 66538	Board of Agriculture, Division of Water Resources Application Number:
---	---	--

3	MARK WELL'S LOCATION WITH AN "X" IN SECTION BOX: N  S
---	--

4	DEPTH OF WELL..... 20ft. WELL'S STATIC WATER LEVEL... 18ft. WELL WAS USED AS: <input checked="" type="radio"/> 1 Domestic 5 Public Water Supply 9 Dewatering <input type="radio"/> 2 Irrigation 6 Oil Field Water Supply 10 Monitoring Well <input type="radio"/> 3 Feedlot 7 Lawn and Garden Only 11 Injection Well <input type="radio"/> 4 Industrial 8 Air Conditioning 12 Other..... Was a chemical/bacteriological sample submitted to Department? Yes.....No... X If yes, mo/day/yr sample was submitted..... Water Well Disinfected: Yes... X ... No..... With Bleach
---	---

5	TYPE OF BLANK CASING USED: 1 Steel 3 RMP (SR) 5 Wrought 7 Fiberglass <input checked="" type="radio"/> 9 Other (specify below) 2 PVC 4 ABS 6 Asbestos-Cement 8 Concrete Tile ... Clay Tile Blank casing diameter... 18 ...in. Was casing pulled? Yes..... No... X ... If yes, how much..... Casing height above or below land surface... 80'in.
---	--

6	GROUT PLUG MATERIAL: 1 Neat cement 2 Cement grout <input checked="" type="radio"/> 3 Bentonite 4 Other..... Grout Plug Intervals: From... 5 ...ft. to... 7 ...ft., From.....ft. toft., From..... to.....ft. What is the nearest source of possible contamination: 1 Septic tank 6 Seepage pit 11 Fuel storage 16 Other (specify below) 2 Sewer lines 7 Pit privy 12 Fertilizer storage 3 Watertight sewer lines 8 Sewage lagoon 13 Insecticide storage 4 Lateral lines 9 Feedyard 14 Abandoned water well 5 Cess Pool <input checked="" type="radio"/> 10 Livestock pens 15 Oil well/Gas well Direction from well? ... Northwest ... How many...? .. 200 ...yards..
---	--

FROM	TO	PLUGGING MATERIALS
0'	5'	dirt fill
5'	7'	Bentonite plug
7'	20'	clean sand

7	CONTRACTOR'S OR LANDOWNER'S CERTIFICATION: This water well was plugged under my jurisdiction and was completed on (mo/day/year)... 10/10/2005 and this record is true to the best of my knowledge and belief. Kansas Water Well Contractor's License No. This Water Well Record was completed on (mo/day/year) ... 10/10/2005 ... under the business name of ... Kansas Dept. of Transportation ... by (signature) ... Duane F. Roeder ...
---	---

INSTRUCTIONS: Use typewriter or ball point pen. Please press firmly and print clearly. Please fill in blanks, underline or circle the correct answers. Send top three copies to Kansas Department of Health and Environment, Bureau of Water, Topeka, Kansas 66620-0001. Telephone: 785/296-3565. Send one to Water Well Owner and retain one for your records.