


1 LOCATION OF WATER WELL:
 County: Nemaha Fraction SE $\frac{1}{4}$ $\frac{1}{4}$ $\frac{1}{4}$ Section Number 27 Township Number 4 Range Number 11 EW
 Distance and direction from nearest town or city street address of well if located within city?

2 WATER WELL OWNER: Joe Wells
 RR#, St. Address, Box #: 1002 4th St
 City, State ZIP Code: Centralia KS 66415
Global Positioning Systems (decimal degrees, min. of 4 digits)
 Latitude: _____
 Longitude: _____
 Elevation: _____
 Datum: _____
 Data Collection Method: _____

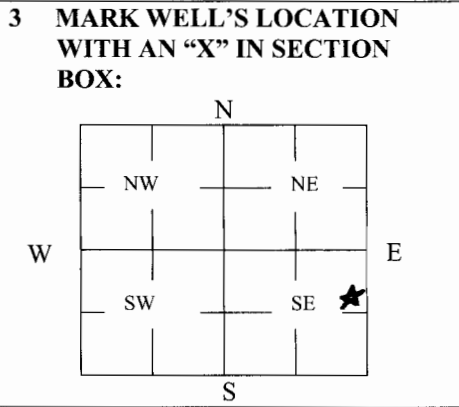

4 DEPTH OF WELL 55 ft.
 WELL'S STATIC WATER LEVEL 16 ft.
 WELL WAS USED AS:
 1 Domestic 5 Public Water Supply 9 Dewatering
 2 Irrigation 6 Oil Field Water Supply 10 Monitoring
 3 Feedlot 7 Domestic (Lawn & Garden) 11 Injection Well
 4 Industrial 8 Air Conditioning 12 Other _____
 Was a chemical/bacteriological sample submitted to Department? Yes _____ No X

5 TYPE OF BLANK CASING USED:
 1 Steel 3 RMP (SR) 5 Wrought 7 Fiberglass 9 Other (Specify below)
 2 PVC 4 ABS 6 Asbestos-Cement 8 Concrete Tile
 Blank casing diameter 12 in. Was casing pulled? Yes _____ No X If yes, how much _____
 Casing height above or below land surface 12 in.

6 GROUT PLUG MATERIAL: 1 Neat cement 2 Cement grout Bentonite 4 Other _____
 Grout Plug Intervals: From 6 ft. to 3 ft., From _____ ft. to _____ ft., From _____ to _____ ft.
 What is the nearest source of possible contamination:
 1 Septic tank 6 Seepage pit 11 Fuel Storage 16 Other (specify below) _____
 2 Sewer lines 7 Pit privy 12 Fertilizer storage _____
 3 Watertight sewer lines 8 Sewage lagoon 13 Insecticide storage _____
 4 Lateral lines 9 Feedyard 14 Abandoned water well Direction from well? NE
 5 Cess pool 10 Livestock pens 15 Oil well/Gas well How many feet? 50

FROM	TO	PLUGGING MATERIALS	FROM	TO	PLUGGING MATERIALS
<u>55</u>	<u>6</u>	<u>Sand</u>			
<u>6</u>	<u>3</u>	<u>Bentonite</u>			
<u>3</u>	<u>0</u>	<u>Topsoil</u>			

7 CONTRACTOR'S OR LANDOWNER'S CERTIFICATION: This water well was plugged under my jurisdiction and was completed on (mo/day/year) 1/24/08 and this record is true to the best of my knowledge and belief. Kansas Water Well Contractor's License No. _____ This Water Well Record was completed on (mo/day/year) 1-24-08 under the business name of Young Backhoe + Trenching Inc. by (signature) Tom Young