


1 LOCATION OF WATER WELL: County: NEMAHA Fraction: SW 1/4 Section Number: 1 Township Number: T 4 S Range Number: R 11 E

Distance and direction from nearest town or city street address of well if located within city? 1 mile west of Centralia, Kansas (not in city)

2 WATER WELL OWNER: BRUCE BACHMAN
 RR#, St. Address, Box # 104 MAIN Board of Agriculture, Division of Water Resources
 City, State, ZIP Code CENTRALIA, KS 66415 Application Number:

3 LOCATE WELL'S LOCATION WITH AN "X" IN SECTION BOX:

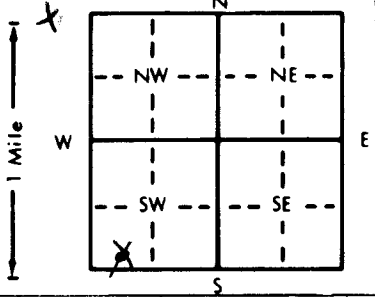

4 DEPTH OF COMPLETED WELL: 26 ft. ELEVATION:

Depth(s) Groundwater Encountered 1. ft. 2. ft. 3. ft.
 WELL'S STATIC WATER LEVEL 26 ft. below land surface measured on mo/day/yr 11-10-93
 Pump test data: Well water was ft. after hours pumping gpm
 Est. Yield gpm: Well water was ft. after hours pumping gpm
 Bore Hole Diameter in. to ft., and in. to ft.
 WELL WATER TO BE USED AS: 5 Public water supply 8 Air conditioning 11 Injection well
 1 Domestic WAS 3 Feedlot 6 Oil field water supply 9 Dewatering 12 Other (Specify below)
 2 Irrigation 4 Industrial 7 Lawn and garden only 10 Monitoring well
 Was a chemical/bacteriological sample submitted to Department? Yes No X; If yes, mo/day/yr sample was submitted
 Water Well Disinfected? Yes X No

5 TYPE OF BLANK CASING USED: 5 Wrought iron 8 Concrete tile CASING JOINTS: Glued X Clamped
 1 Steel 3 RMP (SR) Welded X
 2 PVC 4 ABS 7 Fiberglass Threaded
 6 Asbestos-Cement 9 Other (specify below)

Blank casing diameter 6.0 in. to ft., Dia. in. to ft., Dia. in. to ft.
 Casing height above land surface 36 below weight lbs./ft. Wall thickness or gauge No.

TYPE OF SCREEN OR PERFORATION MATERIAL: 7 PVC 10 Asbestos-cement
 1 Steel 3 Stainless steel 8 RMP (SR) 11 Other (specify) NA
 2 Brass 4 Galvanized steel 9 ABS 12 None used (open hole)

SCREEN OR PERFORATION OPENINGS ARE: 5 Gauzed wrapped 8 Saw cut 11 None (open hole)
 1 Continuous slot 3 Mill slot 6 Wire wrapped 9 Drilled holes
 2 Louvered shutter 4 Key punched 7 Torch cut 10 Other (specify) NA

SCREEN-PERFORATED INTERVALS: From NA ft. to NA ft., From ft. to ft., From ft. to ft.
 GRAVEL PACK INTERVALS: From ft. to ft., From ft. to ft., From ft. to ft.

6 GROUT MATERIAL: 1 Neat cement 2 Cement grout 3 Bentonite 4 Other
 Grout Intervals: From 6.0 ft. to 3.0 ft., From ft. to ft., From ft. to ft.

What is the nearest source of possible contamination: 10 Livestock pens 14 Abandoned water well
 1 Septic tank 4 Lateral lines 7 Pit privy 11 Fuel storage 15 Oil well/Gas well
 2 Sewer lines 5 Cess pool 8 Sewage lagoon 12 Fertilizer storage 16 Other (specify below)
 3 Watertight sewer lines 6 Seepage pit 9 Feedyard 13 Insecticide storage
 Direction from well? EAST How many feet? 380 feet

FROM	TO	LITHOLOGIC LOG	FROM	TO	PLUGGING INTERVALS
<u>26</u>	<u>6</u>	<u>SAND & GRAVEL (5.2 cu.ft.)</u>			
<u>6</u>	<u>3</u>	<u>CLAY (Bentonite) (.85 cu.ft.)</u>			
<u>3</u>	<u>0</u>	<u>Top Soil fill (.60 cu.ft.)</u>			

7 CONTRACTOR'S OR LANDOWNER'S CERTIFICATION: This water well was (1) constructed, (2) reconstructed, or (3) plugged under my jurisdiction and was completed on (mo/day/year) X JANUARY 3, 1994 and this record is true to the best of my knowledge and belief. Kansas Water Well Contractor's License No. 1500 This Water Well Record was completed on (mo/day/yr) X JANUARY 3, 1994 under the business name of by (signature) Bruce Bachman