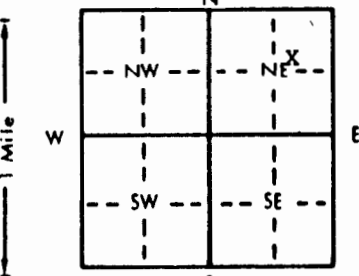


1 LOCATION OF WATER WELL: County: <b>Nemaha</b>	Fraction <b>SW 1/4 NE 1/4 NE 1/4</b>	Section Number <b>12</b>	Township Number <b>T 4 S</b>	Range Number <b>R 11 <u>EW</u></b>
--	---	-----------------------------	---------------------------------	---------------------------------------

Distance and direction from nearest town or city street address of well if located within city?  
**4th Street & Railway Avenue, Centralia, Kansas**

2 WATER WELL OWNER: <b>Mr. Leon White</b> RR#, St. Address, Box #: <b>P.O. Box 102</b> City, State, ZIP Code: <b>Centralia, Ks. 66415</b>	Board of Agriculture, Division of Water Resources Application Number:
---	--

3 LOCATE WELL'S LOCATION WITH AN "X" IN SECTION BOX: 	4 DEPTH OF COMPLETED WELL: <b>13.5</b> ft. ELEVATION: <b>1259.16</b> Depth(s) Groundwater Encountered: 1. <b>4</b> ft. 2. _____ ft. 3. _____ ft. WELL'S STATIC WATER LEVEL: <b>.75</b> ft. below land surface measured on mo/day/yr <b>05-04-93</b> Pump test data: Well water was _____ ft. after _____ hours pumping _____ gpm Est. Yield _____ gpm: Well water was _____ ft. after _____ hours pumping _____ gpm Bore Hole Diameter: <b>7 5/8</b> in. to <b>13.5</b> ft., and _____ in. to _____ ft. WELL WATER TO BE USED AS: 5 Public water supply    8 Air conditioning    11 Injection well 1 Domestic    3 Feedlot    6 Oil field water supply    9 Dewatering    12 Other (Specify below) 2 Irrigation    4 Industrial    7 Lawn and garden only <b>10 Monitoring well</b> Was a chemical/bacteriological sample submitted to Department? Yes _____ No <input checked="" type="checkbox"/> ; If yes, mo/day/yr sample was submitted _____ Water Well Disinfected? Yes _____ No <input checked="" type="checkbox"/>
--	--

5 TYPE OF BLANK CASING USED: 1 Steel    3 RMP (SR) <b>2 PVC</b> 4 ABS	5 Wrought iron    8 Concrete tile 6 Asbestos-Cement    9 Other (specify below) 7 Fiberglass	CASING JOINTS: Glued _____ Clamped _____ Welded _____ Threaded <input checked="" type="checkbox"/>
Blank casing diameter: <b>2</b> in. to <b>3.5</b> ft., Dia _____ in. to _____ ft.	Casing height above land surface: <b>0</b> in., weight _____ lbs./ft. Wall thickness or gauge No. <b>Sch. 40</b>	
TYPE OF SCREEN OR PERFORATION MATERIAL: 1 Steel    3 Stainless steel    5 Fiberglass    8 RMP (SR)    10 Asbestos-cement 2 Brass    4 Galvanized steel    6 Concrete tile    9 ABS    11 Other (specify) _____ 12 None used (open hole)		
SCREEN OR PERFORATION OPENINGS ARE: 1 Continuous slot <b>3 Mill slot</b> 5 Gauzed wrapped    8 Saw cut    11 None (open hole) 2 Louvered shutter    4 Key punched    6 Wire wrapped    9 Drilled holes 7 Torch cut    10 Other (specify) _____		
SCREEN-PERFORATED INTERVALS: From <b>3.5</b> ft. to <b>13.5</b> ft., From _____ ft. to _____ ft. From _____ ft. to _____ ft., From _____ ft. to _____ ft.		
GRAVEL PACK INTERVALS: From <b>2.75</b> ft. to <b>13.5</b> ft., From _____ ft. to _____ ft. From _____ ft. to _____ ft., From _____ ft. to _____ ft.		

6 GROUT MATERIAL: 1 Neat cement <b>2 Cement grout</b> <b>3 Bentonite</b> 4 Other _____	Grout Intervals: From <b>0</b> ft. to <b>1.5</b> ft., From <b>1.5</b> ft. to <b>2.75</b> ft., From _____ ft. to _____ ft.
What is the nearest source of possible contamination: 1 Septic tank    4 Lateral lines    7 Pit privy    10 Livestock pens    14 Abandoned water well 2 Sewer lines    5 Cess pool    8 Sewage lagoon <b>1 Fuel storage</b> 15 Oil well/Gas well 3 Watertight sewer lines    6 Seepage pit    9 Feedyard    12 Fertilizer storage    16 Other (specify below) _____ 13 Insecticide storage _____	
Direction from well? <b>east northeast</b>	How many feet? <b>120</b>

FROM	TO	LITHOLOGIC LOG	FROM	TO	PLUGGING INTERVALS
0	4"	SND & GRVL			
4"	13.5'	BRN SLTY CLY			
					MW4
					Flush mount
					# 00081993

7 CONTRACTOR'S OR LANDOWNER'S CERTIFICATION: This water well was <b>1</b> constructed, (2) reconstructed, or (3) plugged under my jurisdiction and was completed on (mo/day/year) <b>04-27-93</b> and this record is true to the best of my knowledge and belief. Kansas Water Well Contractor's License No. <b>527</b> This Water Well Record was completed on (mo/day/yr) <b>07-29-93</b> under the business name of <b>GeoCore Services, Inc.</b> by (signature) <i>Don Rold</i>	
---	--