


1 LOCATION OF WATER WELL: County: Nemaha Fraction SW 1/4 1/4 1/4 Section Number 36 Township Number 4 Range Number 12 E/W

Distance and direction from nearest town or city street address of well if located within city?

Franklin Street

2 WATER WELL OWNER: City of Corning **Global Positioning Systems** (decimal degrees, min. of 4 digits)
 RR#, St. Address, Box #: 6512 Atlantic St Latitude: _____
 City, State ZIP Code: Corning KS 66417 Longitude: _____
 Elevation: _____
 Datum: _____
 Data Collection Method: _____

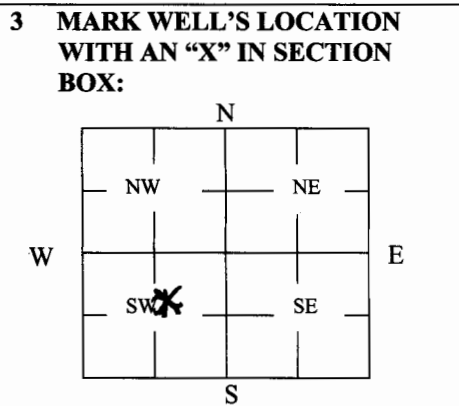

4 DEPTH OF WELL 29 ft.
WELL'S STATIC WATER LEVEL 6 ft.
WELL WAS USED AS:
 Domestic 5 Public Water Supply 9 Dewatering
 Irrigation 6 Oil Field Water Supply 10 Monitoring
 Feedlot 7 Domestic (Lawn & Garden) 11 Injection Well
 Industrial 8 Air Conditioning 12 Other _____
 Was a chemical/bacteriological sample submitted to Department? Yes _____ No _____

5 TYPE OF BLANK CASING USED:
 1 Steel 3 RMP (SR) 5 Wrought 7 Fiberglass 9 Other (Specify below)
 2 PVC 4 ABS 6 Asbestos-Cement 8 Concrete Tile Rock
 Blank casing diameter 36 in. Was casing pulled? Yes No _____ If yes, how much 5 ft
 Casing height above or below land surface 60 in.

6 GROUT PLUG MATERIAL: 1 Neat cement 2 Cement grout 3 Bentonite 4 Other _____
 Grout Plug Intervals: From 5 ft. to 4.5 ft., From _____ ft. to _____ ft., From _____ to _____ ft.

What is the nearest source of possible contamination:
 1 Septic tank 6 Seepage pit 11 Fuel Storage 16 Other (specify below)
 2 Sewer lines 7 Pit privy 12 Fertilizer storage
 3 Watertight sewer lines 8 Sewage lagoon 13 Insecticide storage
 4 Lateral lines 9 Feedyard 14 Abandoned water well Direction from well? west
 5 Cess pool 10 Livestock pens 15 Oil well/Gas well How many feet? 10

FROM	TO	PLUGGING MATERIALS	FROM	TO	PLUGGING MATERIALS
29	6	chlorinated sand			
6	5	rock lining			
5	4.5	Bentonite			
4.5	0	Top Soil			

7 CONTRACTOR'S OR LANDOWNER'S CERTIFICATION: This water well was plugged under my jurisdiction and was completed on (mo/day/year) 10-3-07 and this record is true to the best of my knowledge and belief. Kansas Water Well Contractor's License No. _____. This Water Well Record was completed on (mo/day/year) 10/3/07 under the business name of _____ by (signature) Lo J. Wenzel

INSTRUCTIONS: Use typewriter or ballpoint pen. Please press firmly and print clearly. Please fill in blanks, underline or circle the correct answers. Send top three copies to Kansas Department of Health and Environment, Bureau of Water, Geology Section, 1000 SW Jackson St., Ste. 420, Topeka, Kansas 66612-1367. Telephone: 785/296-5522. Send one to Water Well Owner and retain one for your records. Visit us at <http://www.kdheks.gov/geo/waterwells>.