

CORRECTION(S) TO WATER WELL RECORD (WWC-5)
(to rectify lacking or incorrect information)

County: Nemaha

Location listed as:

Section-Township-Range: 28-4-12 E

Fraction ($\frac{1}{4}$ $\frac{1}{4}$ $\frac{1}{4}$): None Given

Location changed to:

28-45-12 E

NW NW NE

Other changes: Initial statements: _____

Changed to: _____

Comments: _____


verification method: Legal description, well owner's address, position on plat map, location of other well for same owner, and mapping tool & aerial photos on KGS website. initials: DRK date: 12/7/2009

submitted by: Kansas Geological Survey, Data Resources Library, 1930 Constant Ave., Lawrence, KS 66047-3726
to: Kansas Dept of Health & Environment, Bureau of Water, 1000 SW Jackson, Suite 420, Topeka, KS 66612-1367.

WATER WELL PLUGGING RECORD Form WWC-5P KSA 82a-1212 ID NO.

1 LOCATION OF WATER WELL: County: NEMAH County, Fraction 1/4 1/4 1/4, Section Number 28, Township Number 4, Range Number 12 EW. Distance and direction from nearest town or city street address of well if located within city?

2 WATER WELL OWNER: ALAN HEINEN. RR#, St. Address, Box #: 878 I RD. City, State ZIP Code: CORNING, KS. 66417. Global Positioning Systems (decimal degrees, min. of 4 digits) Latitude: Longitude: Elevation: Datum: Data Collection Method:

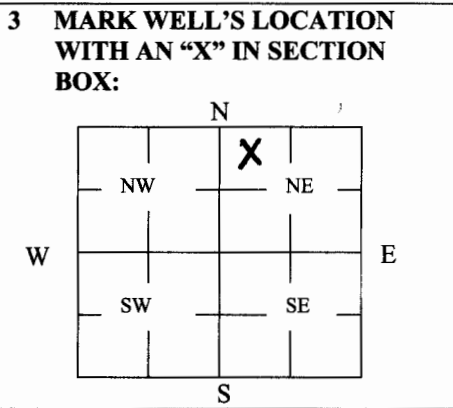

4 DEPTH OF WELL 26 ft. WELL'S STATIC WATER LEVEL 26 ft. WELL WAS USED AS: 1 Domestic, 2 Irrigation, 3 Feedlot, 4 Industrial, 5 Public Water Supply, 6 Oil Field Water Supply, 7 Domestic (Lawn & Garden), 8 Air Conditioning, 9 Dewatering, 10 Monitoring, 11 Injection Well, 12 Other. Was a chemical/bacteriological sample submitted to Department? Yes No

5 TYPE OF BLANK CASING USED: 1 Steel, 2 PVC, 3 RMP (SR), 4 ABS, 5 Wood, 6 Asbestos-Cement, 7 Fiberglass, 8 Concrete Tile, 9 Other (Specify below). Blank casing diameter 12 in. Was casing pulled? Yes X No. If yes, how much 9'. Casing height above or below land surface 60 in.

6 GROUT PLUG MATERIAL: 1 Neat cement, 2 Cement grout, 3 Bentonite, 4 Other. Grout Plug Intervals: From ___ ft. to ___ ft., From ___ ft. to ___ ft., From ___ to ___ ft.

What is the nearest source of possible contamination: 1 Septic tank, 2 Sewer lines, 3 Watertight sewer lines, 4 Lateral lines, 5 Cess pool, 6 Seepage pit, 7 Pit privy, 8 Sewage lagoon, 9 Feedyard, 10 Livestock pens, 11 Fuel Storage, 12 Fertilizer storage, 13 Insecticide storage, 14 Abandoned water well, 15 Oil well/Gas well, 16 Other (specify below). Direction from well? How many feet?

Table with 6 columns: FROM, TO, PLUGGING MATERIALS, FROM, TO, PLUGGING MATERIALS. Rows include: 26' to 6' CHLORINATED SAND, 6' to 5' RMP SR LINING, 5' to 4' BENTONITE, 4' to 0' TOP SOIL.

7 CONTRACTOR'S OR LANDOWNER'S CERTIFICATION: This water well was plugged under my jurisdiction and was completed on (mo/day/year) 9/16/09 and this record is true to the best of my knowledge and belief. Kansas Water Well Contractor's License No. This Water Well Record was completed on (mo/day/year) 10/29/09 under the business name of by (signature) Alan Heinen

INSTRUCTIONS: Use typewriter or ballpoint pen. Please press firmly and print clearly. Please fill in blanks, underline or circle the correct answers. Send top three copies to Kansas Department of Health and Environment, Bureau of Water, Geology Section, 1000 SW Jackson St., Ste. 420, Topeka, Kansas 66612-1367. Telephone: 785/296-5522. Send one to Water Well Owner and retain one for your records. Visit us at http://www.kdheks.gov/geo/waterwells.