

CORRECTION(S) TO WATER WELL RECORD (WWC-5)
(to rectify lacking or incorrect information)

County: Nemaha

Location listed as:

Section-Township-Range: 28-4-12 W

Fraction (1/4 1/4 1/4): None Given

Location changed to:

28-45-12 E

SE NW NW

Other changes: Initial statements: _____

Changed to: _____

Comments: _____

verification method: Legal description, well owner's address, position on plat map, location of other well for same owner, and mapping tool & aerial photos on KGS website. initials: DRD date: 12/7/2009


submitted by: Kansas Geological Survey, Data Resources Library, 1930 Constant Ave., Lawrence, KS 66047-3726
to: Kansas Dept of Health & Environment, Bureau of Water, 1000 SW Jackson, Suite 420, Topeka, KS 66612-1367.

WATER WELL PLUGGING RECORD Form WWC-5P KSA 82a-1212 ID NO. []

1 LOCATION OF WATER WELL: County: NEMHA Fraction 1/4 1/4 1/4 Section Number 28 Township Number 4 Range Number 12 EW

Distance and direction from nearest town or city street address of well if located within city?

2 WATER WELL OWNER: ALAN HEINEM RR#, St. Address, Box #: 878 I RD City, State ZIP Code: CORNING, KS. 66417 Global Positioning Systems (decimal degrees, min. of 4 digits) Latitude: _____ Longitude: _____ Elevation: _____ Datum: _____ Data Collection Method: _____

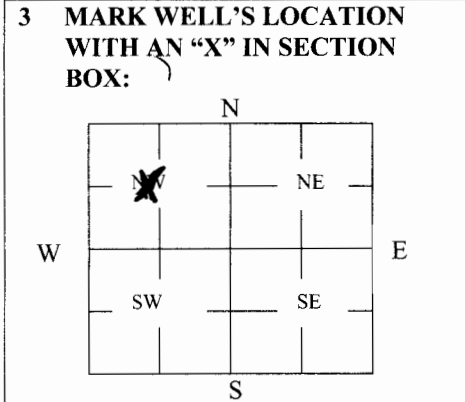

4 DEPTH OF WELL 55 ft. WELL'S STATIC WATER LEVEL 9 ft. WELL WAS USED AS: 1 Domestic 2 Irrigation 3 Feedlot 4 Industrial 5 Public Water Supply 6 Oil Field Water Supply 7 Domestic (Lawn & Garden) 8 Air Conditioning 9 Dewatering 10 Monitoring 11 Injection Well 12 Other _____ Was a chemical/bacteriological sample submitted to Department? Yes _____ No _____

5 TYPE OF BLANK CASING USED: 1 Steel 2 PVC 3 RMP (SR) 4 ABS 5 Wrought 6 Asbestos-Cement 7 Fiberglass 8 Concrete Tile 9 Other (Specify below) _____ Blank casing diameter 13 in. Was casing pulled? Yes X No _____ If yes, how much 6' Casing height above or below land surface 60 in.

6 GROUT PLUG MATERIAL: 1 Neat cement 2 Cement grout 3 Bentonite 4 Other _____ Grout Plug Intervals: From _____ ft. to _____ ft., From _____ ft. to _____ ft., From _____ to _____ ft. What is the nearest source of possible contamination: 1 Septic tank 2 Sewer lines 3 Watertight sewer lines 4 Lateral lines 5 Cess pool 6 Seepage pit 7 Pit privy 8 Sewage lagoon 9 Feedyard 10 Livestock pens 11 Fuel Storage 12 Fertilizer storage 13 Insecticide storage 14 Abandoned water well 15 Oil well/Gas well 16 Other (specify below) _____ Direction from well? EAST How many feet? 200 FT

FROM	TO	PLUGGING MATERIALS	FROM	TO	PLUGGING MATERIALS
<u>55</u>	<u>6</u>	<u>CHLORANTED SAND</u>			
<u>6</u>	<u>5</u>	<u>ROCK LINING</u>			
<u>5</u>	<u>4.5</u>	<u>BENTONITE</u>			
<u>4.5</u>	<u>0</u>	<u>TOP SOIL</u>			

7 CONTRACTOR'S OR LANDOWNER'S CERTIFICATION: This water well was plugged under my jurisdiction and was completed on (mo/day/year) 9/16/09 and this record is true to the best of my knowledge and belief. Kansas Water Well Contractor's License No. _____ This Water Well Record was completed on (mo/day/year) 10/29/09 under the business name of _____ by (signature) Alan Heinem

INSTRUCTIONS: Use typewriter or ballpoint pen. Please press firmly and print clearly. Please fill in blanks, underline or circle the correct answers. Send top three copies to Kansas Department of Health and Environment, Bureau of Water, Geology Section, 1000 SW Jackson St., Ste. 420, Topeka, Kansas 66612-1367. Telephone: 785/296-5522. Send one to Water Well Owner and retain one for your records. Visit us at http://www.kdheks.gov/geo/waterwells.