


LOCATION OF WATER WELL: Nemaha Fraction SE 1/4 SW 1/4 NW 1/4 Section Number 34 Township Number T 4 S Range Number R 12 EAN

name and direction from nearest town or city street address of well if located within city?

approx. 3/4 miles west of Corning

WATER WELL OWNER: KGS
 St. Address, Box #: 1930 constant Avenue
 State, ZIP Code: Lawrence, KS 66044 Board of Agriculture, Division of Water Resources
 Application Number: _____

CATE WELL'S LOCATION WITH "X" IN SECTION BOX: 4 DEPTH OF COMPLETED WELL: 166 ft. ELEVATION: 1350±

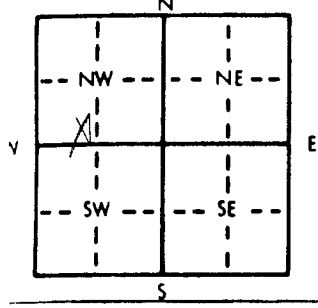

Depth(s) Groundwater Encountered 1. _____ ft. 2. _____ ft. 3. _____ ft.
 WELL'S STATIC WATER LEVEL: 57.5 ft. below land surface measured on mo/day/yr 7/21/86
 Pump test data: Well water was _____ ft. after _____ hours pumping _____ gpm
 Est. Yield _____ gpm; Well water was _____ ft. after _____ hours pumping _____ gpm
 Bore Hole Diameter: 9.78 in. to 166 ft., and _____ in. to _____ ft.
 WELL WATER TO BE USED AS:
 5 Public water supply 8 Air conditioning 11 Injection well
 1 Domestic 3 Feedlot 6 Oil field water supply 9 Dewatering 12 Other (Specify below)
 2 Irrigation 4 Industrial 7 Lawn and garden only 10 Observation well Threatening Nemaha
 Was a chemical/bacteriological sample submitted to Department? Yes _____ No X; If yes, mo/day/yr sample was submitted _____
 Water Well Disinfected? Yes _____ No X

TYPE OF BLANK CASING USED:
 1 Steel 3 RMP (SR) 5 Wrought iron 8 Concrete tile CASING JOINTS: Glued _____ Clamped _____
 2 PVC 4 ABS 6 Asbestos-Cement 9 Other (specify below) Welded _____
 7 Fiberglass _____ Threaded _____

casing diameter 5 in. to 166 ft., Dia _____ in. to _____ ft., Dia _____ in. to _____ ft.
 g height above land surface 24 in., weight _____ lbs./ft. Wall thickness or gauge No. SDR26

TYPE OF SCREEN OR PERFORATION MATERIAL:
 1 Steel 3 Stainless steel 5 Fiberglass 8 RMP (SR) 10 Asbestos-cement 11 Other (specify) _____
 2 Brass 4 Galvanized steel 6 Concrete tile 9 ABS 12 None used (open hole)

SCREEN OR PERFORATION OPENINGS ARE:
 1 Continuous slot 3 Mill slot .035 5 Gauzed wrapped 8 Saw cut 11 None (open hole)
 2 Louvered shutter 4 Key punched 7 Torch cut 9 Drilled holes 12 Other (specify) _____

SCREEN-PERFORATED INTERVALS: From 158 ft. to 166 ft., From _____ ft. to _____ ft., From _____ ft. to _____ ft.
 GRAVEL PACK INTERVALS: From 152 ft. to 166 ft., From _____ ft. to _____ ft., From _____ ft. to _____ ft.

OUT MATERIAL: 1 Neat cement 2 Cement grout 3 Bentonite 4 Other _____
 Intervals: From 0 ft. to 166 ft., From _____ ft. to _____ ft., From _____ ft. to _____ ft.

is the nearest source of possible contamination:
 1 Septic tank 4 Lateral lines 7 Pit privy 10 Livestock pens 14 Abandoned water well
 2 Sewer lines 5 Cess pool 8 Sewage lagoon 11 Fuel storage 15 Oil well/Gas well
 3 Watertight sewer lines 6 Seepage pit 9 Feedyard 12 Fertilizer storage 16 Other (specify below)
 13 Insecticide storage _____
 How many feet? _____

FROM	TO	LITHOLOGIC LOG	FROM	TO	LITHOLOGIC LOG

Plugging Report

(See attached original well record)

CONTRACTOR'S OR LANDOWNER'S CERTIFICATION: This water well was (1) constructed, (2) reconstructed, or (3) plugged under my jurisdiction and was dated on (mo/day/year) 1/16/86 10/20 - 21/86; 12/18/86 and this record is true to the best of my knowledge and belief. Kansas Well Contractor's License No. _____ This Water Well Record was completed on (mo/day/yr) 12/19/86 - 7/88
 the business name of KGS by (signature)

INSTRUCTIONS: Use typewriter or ball point pen. PLEASE PRESS FIRMLY and PRINT clearly. Please fill in blanks, underline or circle the correct answers. Send top three copies to Kansas Department of Health and Environment, Office of Oil Field and Environmental Geology, Regulation and Permitting Section, Topeka, Kansas 66620-7500, Telephone: 913-862-9360. Send one to WATER WELL OWNER and retain one for your records.