


1 LOCATION OF WATER WELL: Fraction SW 1/4 SE 1/4 NW 1/4 Section Number 32 Township Number T 4 S Range Number R 13 **EW**
 County: NEMAHA

Distance and direction from nearest town or city street address of well if located within city?
 2 1/2 east of Corning

2 WATER WELL OWNER: J-6 Farms
 RR#, St. Address, Box #: Rt. 1 Box 86 Board of Agriculture, Division of Water Resources
 City, State, ZIP Code: Corning, KS 66417 Application Number:

3 LOCATE WELL'S LOCATION WITH AN "X" IN SECTION BOX: 4 DEPTH OF COMPLETED WELL: 135' ft. ELEVATION:

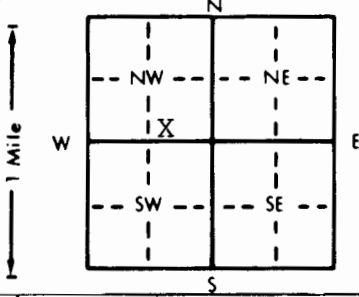

Depth(s) Groundwater Encountered 1. ft. 2. ft. 3. ft.
 WELL'S STATIC WATER LEVEL 45' ft. below land surface measured on mo/day/yr 12-13-96
 Pump test data: Well water was ft. after hours pumping gpm
 Est. Yield 100 gpm: Well water was ft. after hours pumping gpm
 Bore Hole Diameter . . . 12" . . . in. to . . . 135' 140' . . . ft., and in. to ft.
 WELL WATER TO BE USED AS: 5 Public water supply 8 Air conditioning 11 Injection well
 1 Domestic 3 Feedlot 6 Oil field water supply 9 Dewatering 12 Other (Specify below)
 2 Irrigation 4 Industrial 7 Lawn and garden only 10 Monitoring well
 Was a chemical/bacteriological sample submitted to Department? Yes No X; if yes, mo/day/yr sample was submitted
 Water Well Disinfected? Yes X No

5 TYPE OF BLANK CASING USED: 5 Wrought iron 8 Concrete tile CASING JOINTS: Glued X Clamped
 1 Steel 3 RMP (SR) 6 Asbestos-Cement 9 Other (specify below) Welded
 2 PVC 4 ABS 7 Fiberglass Threaded

Blank casing diameter . . . 5" . . . in. to . . . 0-60 . . . ft., Dia . . . 5" . . . in. to . . . 100-115 . . . ft., Dia in. to ft.
 Casing height above land surface . . . 24" . . . in., weight . . . 2.82 . . . lbs./ft. Wall thickness or gauge No. 258

TYPE OF SCREEN OR PERFORATION MATERIAL: 7 PVC 10 Asbestos-cement
 1 Steel 3 Stainless steel 5 Fiberglass 8 RMP (SR) 11 Other (specify)
 2 Brass 4 Galvanized steel 6 Concrete tile 9 ABS 12 None used (open hole)

SCREEN OR PERFORATION OPENINGS ARE: 5 Gauzed wrapped 8 Saw cut 11 None (open hole)
 1 Continuous slot 3 Mill slot 6 Wire wrapped 9 Drilled holes
 2 Louvered shutter 4 Key punched 7 Torch cut 10 Other (specify)

SCREEN-PERFORATED INTERVALS: From . . . 60 . . . ft. to . . . 100 . . . ft., From ft. to ft.
 From . . . 115 . . . ft. to . . . 130 . . . ft., From ft. to ft.
 GRAVEL PACK INTERVALS: From . . . 25 . . . ft. to . . . 135 . . . ft., From ft. to ft.
 From ft. to ft., From ft. to ft.

6 GROUT MATERIAL: 1 Neat cement 2 Cement grout 3 Bentonite 4 Other
 Grout intervals: From . . . 0 . . . ft. to . . . 25 . . . ft., From ft. to ft., From ft. to ft.

What is the nearest source of possible contamination:
 1 Septic tank 4 Lateral lines 7 Pit privy 10 Livestock pens 14 Abandoned water well
 2 Sewer lines 5 Cess pool 8 Sewage lagoon 11 Fuel storage 15 Oil well/Gas well
 3 Watertight sewer lines 6 Seepage pit 9 Feedyard 12 Fertilizer storage 16 Other (specify below) creek.
 13 Insecticide storage

Direction from well? east How many feet? 600

FROM	TO	LITHOLOGIC LOG	FROM	TO	PLUGGING INTERVALS
0	3	Top Soil			
3	58	Clay-Brown			
58	63	Fine Sand-Coarse Sand-Brown			
63	69	FS-CS-Med-Pea Gravel-Brown			
69	83	Fine Sand-Brown			
83	92	Clay-Brown-Silty			
92	94	Fine Sand-Brown			
94	98	FS-CS-Med Gravel, Brown			
98	108	Clay-Brown-Silty			
108	110	Fine Sand-Brown			
110	120	Clay-Brown-Silty			
120	122	FS-CS-Med Gravel, Dirty			
122	130	FS-Brown-Dirty			
130	140	Clay-Brown			

7 CONTRACTOR'S OR LANDOWNER'S CERTIFICATION: This water well was (1) constructed, (2) reconstructed, or (3) plugged under my jurisdiction and was completed on (mo/day/year) 12/13/96 and this record is true to the best of my knowledge and belief. Kansas Water Well Contractor's License No. 182 This Water Well Record was completed on (mo/day/yr) 1-2-97 under the business name of STRADER DRILLING CO., INC. by (signature) Dale Strader

OFFICE USE ONLY
T
R
EW
SEC.
1/4
1/4
1/4