


1 LOCATION OF WATER WELL: County: NEMAHA	Fraction SE ¼ NE ¼ SE ¼	Section Number 12	Township Number T 4 S	Range Number R 13 EW
---------------------------------------------	----------------------------	----------------------	--------------------------	-------------------------

Distance and direction from nearest town or city street address of well if located within city?
1½ east, 3½ north of Goff

2 WATER WELL OWNER: Betty King
RR#, St. Address, Box #: Rt. 2 Box 22
City, State, ZIP Code: Goff, KS 66428
Board of Agriculture, Division of Water Resources
Application Number:

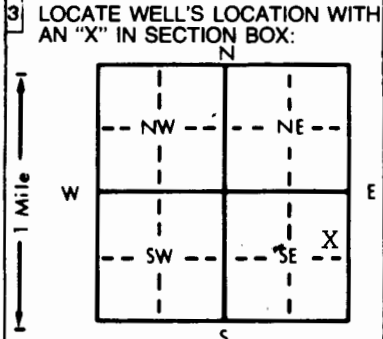

4 DEPTH OF COMPLETED WELL: 239 ft. ELEVATION:
Depth(s) Groundwater Encountered 1. ft. 2. ft. 3. ft.
WELL'S STATIC WATER LEVEL: 87' ft. below land surface measured on mo/day/yr 10-24-91
Pump test data: Well water was ft. after hours pumping gpm
Est. Yield: 150 gpm; Well water was ft. after hours pumping gpm
Bore Hole Diameter: 8 3/4 in. to ft., and in. to ft.
WELL WATER TO BE USED AS:
5 Public water supply 8 Air conditioning 11 Injection well
1 Domestic 3 Feedlot 6 Oil field water supply 9 Dewatering 12 Other (Specify below)
2 Irrigation 4 Industrial 7 Lawn and garden only 10 Monitoring well
Was a chemical/bacteriological sample submitted to Department? Yes No X; If yes, mo/day/yr sample was submitted
Water Well Disinfected? Yes X No

5 TYPE OF BLANK CASING USED:
1 Steel 3 RMP (SR) 5 Wrought iron 8 Concrete tile CASING JOINTS: Glued X Clamped
2 PVC 4 ABS 6 Asbestos-Cement 9 Other (specify below) Welded
7 Fiberglass Threaded
Blank casing diameter 5" in. to 0-224 ft., Dia in. to ft., Dia in. to ft.
Casing height above land surface 24" in., weight 2.82 lbs./ft. Wall thickness or gauge No. 258
TYPE OF SCREEN OR PERFORATION MATERIAL:
1 Steel 3 Stainless steel 5 Fiberglass 7 PVC 10 Asbestos-cement
2 Brass 4 Galvanized steel 6 Concrete tile 8 RMP (SR) 11 Other (specify)
9 ABS 12 None used (open hole)
SCREEN OR PERFORATION OPENINGS ARE:
1 Continuous slot 3 Mill slot 5 Gauzed wrapped 8 Saw cut 11 None (open hole)
2 Louvered shutter 4 Key punched 6 Wire wrapped 9 Drilled holes
7 Torch cut 10 Other (specify)
SCREEN-PERFORATED INTERVALS: From 224 ft. to 239 ft., From ft. to ft.
GRAVEL PACK INTERVALS: From 25 ft. to 239 ft., From ft. to ft.

6 GROUT MATERIAL: 1 Neat cement 2 Cement grout 3 Bentonite 4 Other
Grout Intervals: From 0 ft. to 25 ft., From ft. to ft., From ft. to ft.
What is the nearest source of possible contamination:
1 Septic tank 4 Lateral lines 7 Pit privy 10 Livestock pens 14 Abandoned water well
2 Sewer lines 5 Cess pool 8 Sewage lagoon 11 Fuel storage 15 Oil well/Gas well
3 Watertight sewer lines 6 Seepage pit 9 Feedyard 12 Fertilizer storage 16 Other (specify below)
13 Insecticide storage
Direction from well? west How many feet? 250'

FROM	TO	LITHOLOGIC LOG	FROM	TO	PLUGGING INTERVALS
0	4	Top Soil	132	139	Clay-Blue
4	23	Clay-Brown	139	141	Boulders
23	28	Clay-Blue	141	146	Clay-Blue
28	34	Clay-Brown	146	147	Boulders
34	35	Fine Sand-Brown	147	176	Clay-Blue
35	46	Clay-Blue	176	214	Fine Silt-Blue
46	49	Fine Sand-Coarse Sand-Med-Pea Gr	214	225	FS-Cs-Med-Gravel
49	64	Clay-Blue	225	235	" " " -Pea Gravel
64	65	Boulders	235	239	Shale-Grey
65	74	Clay-Blue			
74	75	Boulders			
75	90	Clay-Blue			
90	96	Fine Sand-Blue			
96	131	Clay-Blue			
131	132	Fine Sand-Blue			

7 CONTRACTOR'S OR LANDOWNER'S CERTIFICATION: This water well was (1) constructed, (2) reconstructed, or (3) plugged under my jurisdiction and was completed on (mo/day/year) 10-24-91 and this record is true to the best of my knowledge and belief. Kansas Water Well Contractor's License No. 182 This Water Well Record was completed on (mo/day/yr) 11-12-91 under the business name of STRADER DRILLING CO., INC. by (signature) Dale Skren

INSTRUCTIONS: Use typewriter or ball point pen. PLEASE PRESS FIRMLY and PRINT clearly. Please fill in blanks, underline or circle the correct answers. Send top three copies to Kansas Department of Health and Environment, Bureau of Water, Topeka, Kansas 66620-0001. Telephone: 913-296-5545. Send one to WATER WELL OWNER and retain one for your records.

OFFICE USE ONLY
T
R
EW
SEC.
1/4
1/4
1/4