


1 LOCATION OF WATER WELL: Fraction SW 1/4 SE 1/4 NW 1/4 Section Number 11 Township Number T 4 S Range Number R 14 E
 County: Nova

Distance and direction from nearest town or city street address of well if located within city?
1 West of Granada

2 WATER WELL OWNER: Alan Keehn
 RR#, St. Address, Box #: 321 South 12th St. Board of Agriculture, Division of Water Resources
 City, State, ZIP Code: Sabetha, Kansas 66534 Application Number:

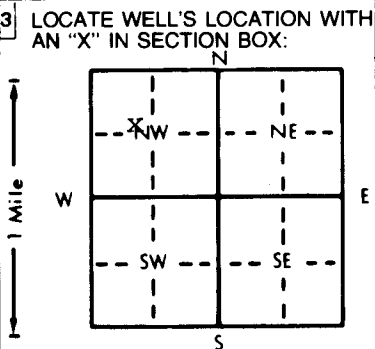

4 DEPTH OF COMPLETED WELL: 40 ft. ELEVATION: _____
 Depth(s) Groundwater Encountered: 1. _____ ft. 2. _____ ft. 3. _____ ft.
 WELL'S STATIC WATER LEVEL: 22 ft. below land surface measured on mo/day/yr 7-25-95
 Pump test data: Well water was _____ ft. after _____ hours pumping _____ gpm
 Est. Yield: 8 gpm: Well water was _____ ft. after _____ hours pumping _____ gpm
 Bore Hole Diameter: 10 in. to _____ ft., and _____ in. to _____ ft.
 WELL WATER TO BE USED AS:
 5 Public water supply 8 Air conditioning 11 Injection well
1 Domestic 3 Feedlot 6 Oil field water supply 9 Dewatering 12 Other (Specify below)
2 Irrigation 4 Industrial 7 Lawn and garden only 10 Monitoring well
 Was a chemical/bacteriological sample submitted to Department? Yes _____ No X If yes, mo/day/yr sample was submitted _____
 Water Well Disinfected? Yes X No _____

5 TYPE OF BLANK CASING USED:
 1 Steel 3 RMP (SR) 5 Wrought iron 8 Concrete tile CASING JOINTS: Glued X Clamped _____
 2 PVC 4 ABS 6 Asbestos-Cement 9 Other (specify below) Welded _____
 7 Fiberglass Threaded _____
 Blank casing diameter: 5 in. to 40-15 ft., Dia. 5" in. to 33-40 ft., Dia. _____ in. to _____ ft.
 Casing height above land surface: 24 in., weight 2.82 lbs./ft. Wall thickness or gauge No. 258
 TYPE OF SCREEN OR PERFORATION MATERIAL:
 1 Steel 3 Stainless steel 5 Fiberglass 7 PVC 10 Asbestos-cement
 2 Brass 4 Galvanized steel 6 Concrete tile 8 RMP (SR) 11 Other (specify) _____
 9 ABS 12 None used (open hole)
 SCREEN OR PERFORATION OPENINGS ARE:
 1 Continuous slot 3 Mill slot 5 Gauzed wrapped 8 Saw cut 11 None (open hole)
 2 Louvered shutter 4 Key punched 6 Wire wrapped 9 Drilled holes
 7 Torch cut 10 Other (specify) _____
 SCREEN-PERFORATED INTERVALS: From 15-33' ft. to _____ ft., From _____ ft. to _____ ft.
 From _____ ft. to _____ ft., From _____ ft. to _____ ft.
 GRAVEL PACK INTERVALS: From 14 ft. to 40 ft., From _____ ft. to _____ ft.
 From _____ ft. to _____ ft., From _____ ft. to _____ ft.

6 GROUT MATERIAL: 1 Neat cement 2 Cement grout 3 Bentonite 4 Other _____
 Grout Intervals: From 0 ft. to 14 ft., From _____ ft. to _____ ft., From _____ ft. to _____ ft.
 What is the nearest source of possible contamination:
 1 Septic tank 4 Lateral lines 7 Pit privy 10 Livestock pens 14 Abandoned water well
 2 Sewer lines 5 Cess pool 8 Sewage lagoon 11 Fuel storage 15 Oil well/Gas well
 3 Watertight sewer lines 6 Seepage pit 9 Feedyard 12 Fertilizer storage 16 Other (specify below) _____
 13 Insecticide storage Drainage ditch _____
 Direction from well? East How many feet? 150

FROM	TO	LITHOLOGIC LOG	FROM	TO	PLUGGING INTERVALS
0	1	Top soil			
1	5	brown clay			
5	13	brown fine sand			
13	30	brown clay			
13	30	f.s.c.s.-med. to pea gravel $\frac{1}{2}$ "			
30	40	brown clay			
40	47	blue clay			

* Note: Permission to shallow grout from Don Taylor 7-28-95

7 CONTRACTOR'S OR LANDOWNER'S CERTIFICATION: This water well was (1) constructed, (2) reconstructed, or (3) plugged under my jurisdiction and was completed on (mo/day/year) 7-25-1995 and this record is true to the best of my knowledge and belief. Kansas Water Well Contractor's License No. 182 This Water Well Record was completed on (mo/day/yr) 9-6-95 under the business name of Strader drilling co. inc. by (signature) Don Taylor

OFFICE USE ONLY
T
R
EW
SEC