

LOCATION OF WATER WELL: Fraction NE 1/4 SE 1/4 SE 1/4 Section Number 35 Township Number T 4 S Range Number R 14 EW

Distance and direction from nearest town or city street address of well if located within city?


1 1/4 mile N. of Wetmore

WATER WELL OWNER: KGS

St. Address, Box # :
State, ZIP Code :

Board of Agriculture, Division of Water Resources
Application Number:

CATEGORY OF WELL'S LOCATION WITH "X" IN SECTION BOX:

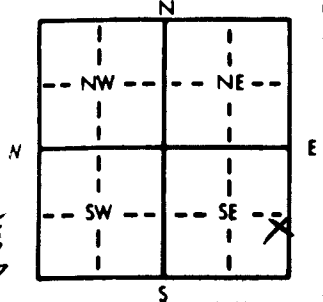

DEPTH OF COMPLETED WELL: 35 ft. ELEVATION: ~1090

Depth(s) Groundwater Encountered: 1. 4.8 ft. 2. 35 ft. 3. 35 ft.

WELL'S STATIC WATER LEVEL: 4.8 ft. below land surface measured on 4/16/86 and 12/11/86

Pump test data: Well water was _____ ft. after _____ hours pumping _____ gpm

Est. Yield _____ gpm Well water was _____ ft. after _____ hours pumping _____ gpm

Bore Hole Diameter: 6 1/2 in. to 35.5 ft., and _____ in. to _____ ft.

WELL WATER TO BE USED AS: 5 Public water supply 8 Air conditioning 11 Injection well

1 Domestic 3 Feedlot 6 Oil field water supply 9 Dewatering 12 Other (Specify below)

2 Irrigation 4 Industrial 7 Lawn and garden only 10 Observation well Monitoring research

Was a chemical/bacteriological sample submitted to Department? Yes _____ No X; If yes, mo/day/yr sample was submitted

Water Well Disinfected? Yes _____ No X

TYPE OF BLANK CASING USED: 5 Wrought iron 8 Concrete tile CASING JOINTS: Glued _____ Clamped _____

1 Steel 3 RMP (SR) 6 Asbestos-Cement 9 Other (specify below) Welded _____

2 PVC 4 ABS 7 Fiberglass _____ Threaded Yes

casing diameter 2 in. to 35 ft., Dia _____ in. to _____ ft., Dia _____ in. to _____ ft.

height above land surface 1 ft. 8 in., weight _____ lbs./ft. Wall thickness or gauge No. Sch. 80

TYPE OF SCREEN OR PERFORATION MATERIAL: 7 PVC 10 Asbestos-cement

1 Steel 3 Stainless steel 5 Fiberglass 8 RMP (SR) 11 Other (specify) _____

2 Brass 4 Galvanized steel 6 Concrete tile 9 ABS 12 None used (open hole)

TYPE OF SCREEN OR PERFORATION OPENINGS ARE: 5 Gauzed wrapped 8 Saw cut 11 None (open hole)

3 Continuous slot 3 Mill slot .01 6 Wire wrapped 9 Drilled holes

Louvered shutter 4 Key punched 7 Torch cut 10 Other (specify) _____

SCREEN-PERFORATED INTERVALS: From 28 ft. to 35 ft., From _____ ft. to _____ ft.

From _____ ft. to _____ ft., From _____ ft. to _____ ft.

GRAVEL PACK INTERVALS: From 23 ft. to 35.5 ft., From _____ ft. to _____ ft.

From _____ ft. to _____ ft., From _____ ft. to _____ ft.

GRAVEL PACK MATERIAL: 1 Neat cement 2 Cement grout 3 Bentonite 4 Other _____

Intervals: From 0 ft. to 23 ft., From _____ ft. to _____ ft., From _____ ft. to _____ ft.

Is the nearest source of possible contamination: 10 Livestock pens 14 Abandoned water well

1 Septic tank 4 Lateral lines 7 Pit privy 11 Fuel storage 15 Oil well/Gas well

2 Sewer lines 5 Cess pool 8 Sewage lagoon 12 Fertilizer storage 16 Other (specify below)

3 Watertight sewer lines 6 Seepage pit 9 Feedyard 13 Insecticide storage _____

How far from well? _____ How many feet? _____

How far from well? _____ How many feet? _____

CONTRACTOR'S OR LANDOWNER'S CERTIFICATION: This water well was (1) constructed, (2) reconstructed, or (3) plugged under my jurisdiction and was installed on (mo/day/year) 4/16/86 9/10/86, but not developed then and this record is true to the best of my knowledge and belief, Kansas Well Contractor's License No. _____ This Water Well Record was completed on (mo/day/yr) 10/13/86 12/87 7/88 the business name of Ron Johnson driller by (signature)

INSTRUCTIONS: Use typewriter or ball point pen. PLEASE PRESS FIRMLY and PRINT clearly. Please fill in blanks, underline or circle the correct answers. Send top three copies to Kansas Department of Health and Environment, Office of Oil Field and Environmental Geology, Regulation and Permitting Section, Topeka, Kansas 66620-7500, Telephone: 913-862-9360. Send one WATER WELL OWNER and retain one for your records.

DEPTH	TO	LITHOLOGIC LOG	FROM	TO	LITHOLOGIC LOG
0	3'	1 Top Soil			
3'	6'	light brown clay (Sandy)			
6'	11'	light brown TAN clay			
11'	13'	yellowish - TAN clay with rounded chert gravel 1/4 in diam.			
13'	26'	Brown and TAN slightly sandy silty clay with some gravel			
26'	35.5'	Gray silty clay with sand and gravel			