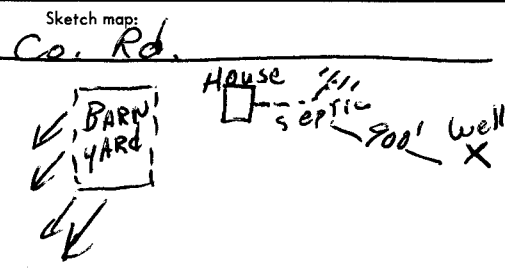


30

USE TYPEWRITER OR BALL  
POINT PEN-PRESS FIRMLY,  
PRINT CLEARLY.

WATER WELL RECORD  
KSA 82a-1201-1215  
from sketch & topo,  
ABB or ABA or AAB  
USE ABA?

approved  
5/10  
(changed loc  
& elev.)  
Kansas Department of Health and  
Environment-Division of Environment  
(Water well Contractors)  
Topeka, Kansas 66620

1. Location of well:		County <b>Brown</b>	Fraction <b>NW 1/4 NW 1/4 NE 1/4</b>	Section number <b>3</b>	Township number <b>T 4 S</b>	Range number <b>R 15 E</b>
2. Distance and direction from nearest town or city: <b>7.5 - 1/2 E.</b>		3. Owner of well: <b>RAY SKOCH</b>				
Street address of well location if in city: <b>Fairview, KS</b>		R.R. or street: <b>RR</b>				
		City, state, zip code: <b>POWHATAN, KS</b>				
4. Locate with "X" in section below:		Sketch map: <b>Co. Rd.</b> 				
5. Type and color of material		From		To		
<b>Top Soil</b>		<b>0</b>		<b>3</b>		
<b>Yellow Clay</b>		<b>3</b>		<b>10</b>		
<b>Brown Graty Clay</b>		<b>10</b>		<b>14</b>		
<b>Yellow Sand Stone</b>		<b>14</b>		<b>21</b>		
<b>Grey Shale</b>		<b>21</b>		<b>35</b>		
<b>Grey Limestone</b>		<b>35</b>		<b>40</b>		
<b>Grey Shale</b>		<b>40</b>		<b>57</b>		
<b>Grey Limestone - Water</b>		<b>57</b>		<b>60</b>		
<b>Grey Shaley Limestone</b>		<b>60</b>		<b>65</b>		
<b>Blue Shale</b>		<b>65</b>		<b>75</b>		
<b>Grey Limestone</b>		<b>75</b>		<b>80</b>		
<b>(3580 MPL - Chloride s Casing Pulled - Grouted And Hole Plugged)</b>						
18. Elevation: <b>1042</b>		19. Remarks: <b>3580 CL- only for Chem. Analy.</b> <b>DUB</b>				
Topography: <input checked="" type="checkbox"/> Hill <input type="checkbox"/> Slope <input type="checkbox"/> Upland <input type="checkbox"/> Valley		20. Water well contractor's certification: This well was drilled under my jurisdiction and this report is true to the best of my knowledge and belief. <b>Strader Dalg Co Inc 182</b> Business name License No. Address <b>RT 1 HAITON, KS</b> Signed <b>Dale Strader</b> Date <b>4-28-77</b> Authorized representative				

Forward the white, blue and pink copies to the Department of Health and Environment

Form WWC-5

BR = 1028

▽ = 1022

T 4 S 15 E  
R 15 E  
Sec 3  
NW 1/4 NE 1/4