

51

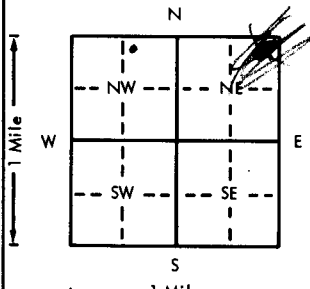
VR  
JD

USE TYPEWRITER OR BALL  
POINT PEN-PRESS FIRMLY,  
PRINT CLEARLY.

WATER WELL RECORD  
KSA 82a-1201-1215

Kansas Department of Health and  
Environment-Division of Environment  
(Water well Contractors)  
Topeka, Kansas 66620

NW NE NW

1. Location of well:		County <b>BROWN</b>	Fraction <del>NE 1/4</del> <b>NE 1/4</b>	Section number <b>2</b>	Township number T <b>4</b> S	Range number R <b>16</b> <b>EW</b>
2. Distance and direction from nearest town or city: <b>2 N</b> Street address of well location if in city: <b>OF MERCIER</b>				3. Owner of well: <b>RICHARD HALL</b> R.R. or street: City, state, zip code: <b>HORTON</b>		
4. Locate with "X" in section below:		Sketch map:		6. Bore hole dia. <b>10</b> in. Completion date Well depth <b>100</b> ft. <b>11-30-76</b>		
				7. <input checked="" type="checkbox"/> Cable tool <input checked="" type="checkbox"/> Rotary <input type="checkbox"/> Driven <input type="checkbox"/> Dug <input type="checkbox"/> Hollow rod <input type="checkbox"/> Jetted <input type="checkbox"/> Bored <input type="checkbox"/> Reverse rotary		
5. Type and color of material				8. Use: <input checked="" type="checkbox"/> Domestic <input type="checkbox"/> Public supply <input type="checkbox"/> Industry <input type="checkbox"/> Irrigation <input type="checkbox"/> Air conditioning <input type="checkbox"/> Stock <input type="checkbox"/> Lawn <input type="checkbox"/> Oil field water <input type="checkbox"/> Other		
				9. Casing: Material <b>PVC</b> Height: <b>Above</b> or below Threaded <input type="checkbox"/> Welded <input type="checkbox"/> Surface <b>24</b> in. RMP <input type="checkbox"/> PVC <b>9L</b> Weight <b>258</b> lbs./ft. <b>74</b> Dia. <b>5</b> in. to <b>100</b> ft. depth Wall thickness: inches or Dia. <input type="checkbox"/> in. to <input type="checkbox"/> ft. depth Gauge No. <b>279-260</b> <b>MNC</b>		
				10. Screen: Manufacturer's name <b>PUMPCO</b> Type <b>PVC</b> Dia. <b>5</b> Slot/gauze <b>1020</b> Length <b>20</b> Set between <b>30</b> ft. and <b>50</b> ft. Gravel pack? <input checked="" type="checkbox"/> Size range of material <b>1030X1060</b>		
				11. Static water level: <b>35</b> ft. below land surface Date <b>11-30-76</b>		
				12. Pumping level below land surfaces: ____ ft. after ____ hrs. pumping ____ g.p.m. ____ ft. after ____ hrs. pumping ____ g.p.m. Estimated maximum yield <b>2</b> g.p.m.		
				13. Water sample submitted: <b>Yes</b> <input checked="" type="checkbox"/> <b>No</b> <input type="checkbox"/> Date		
				14. Well head completion: <b>CAP</b> ____ Pitless adapter <b>24</b> inches above grade		
				15. Well grouted? <input checked="" type="checkbox"/> With: <input checked="" type="checkbox"/> Neat cement <input type="checkbox"/> Bentonite <input type="checkbox"/> Concrete Depth: From <b>5</b> ft. to <b>15</b> ft.		
				16. Nearest source of possible contamination: ft. <b>400</b> Direction <b>NE</b> Type <b>SEPTIC</b> Well disinfected upon completion? <input checked="" type="checkbox"/> Yes <input type="checkbox"/> No		
				17. Pump: <input checked="" type="checkbox"/> Not installed Manufacturer's name Model number HP Volts Length of drop pipe ____ ft. capacity ____ g.p.m. Type: <input type="checkbox"/> Submersible <input type="checkbox"/> Turbine <input type="checkbox"/> Jet <input type="checkbox"/> Reciprocating <input type="checkbox"/> Centrifugal <input type="checkbox"/> Other		
18. Elevation: <b>1133</b>		19. Remarks: <b>OWNER WILL INSTAL SLAB</b>		20. Water well contractor's certification: This well was drilled under my jurisdiction and this report is true to the best of my knowledge and belief. <b>Stender Dickey Co Inc 182</b> Business name License No. Address <b>RT1 Horton, KS</b> Signed <b>Dale Parker</b> Date <b>11-30-76</b> Authorized representative		

Forward the white, blue and pink copies to the Department of Health and Environment

Form WWC-5

BR = 1098  $\Sigma$  = 1098