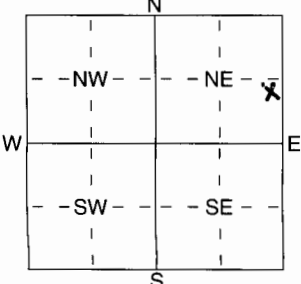


1 LOCATION OF WATER WELL: Fraction NE 1/4 SE 1/4 NE 1/4 Section Number 28 Township Number T 4 S Range Number R 17 EW  
 County: Brown

Distance and direction from nearest town or city street address of well if located within city?  
From East Edge of Horton 1/2 mi. East + 3/4 mi. North 300' West Approx.

2 WATER WELL OWNER: Carl Gasper  
 RR#, St. Address, Box # : 1161 Mallard Rd Board of Agriculture, Division of Water Resources  
 City, State, ZIP Code : Horton, KS 66439 Application Number:

3 LOCATE WELL'S LOCATION WITH AN "X" IN SECTION BOX:  
  
 4 DEPTH OF COMPLETED WELL 81 ft. ELEVATION:  
 Depth(s) Groundwater Encountered 1 ..... ft. 2 ..... ft. 3 ..... ft.  
 WELL'S STATIC WATER LEVEL 22 ft. below land surface measured on mo/day/yr 8-23-05  
 Pump test data: Well water was ..... ft. after ..... hours pumping ..... gpm  
 Est. Yield 2 gpm: Well water was ..... ft. after ..... hours pumping ..... gpm  
 WELL WATER TO BE USED AS: 5 Public water supply 8 Air conditioning 11 Injection well  
 1 Domestic 3 Feedlot 6 Oil field water supply 9 Dewatering 12 Other (Specify below)  
 2 Irrigation 4 Industrial 7 Domestic (lawn & garden) 10 Monitoring well .....  
 Was a chemical/bacteriological sample submitted to Department? Yes ..... No X .....; If yes, mo/day/yr sample was submitted  
 Water Well Disinfected? Yes X No

5 TYPE OF BLANK CASING USED: 5 Wrought iron 8 Concrete tile CASING JOINTS: Glued X Clamped .....  
 1 Steel 3 RMP (SR) 6 Asbestos-Cement 9 Other (specify below) Welded .....  
 2 PVC 4 ABS 7 Fiberglass Threaded .....  
 Blank casing diameter 5 in. to 31 ft., Dia 5 in. to 41-07 ft., Dia 5 in. to 77-81 ft.  
 Casing height above land surface 18 in., weight 2.87 lbs./ft. Wall thickness or gauge No. SDR 21  
 TYPE OF SCREEN OR PERFORATION MATERIAL: 7 PVC 10 Asbestos-Cement  
 1 Steel 3 Stainless Steel 5 Fiberglass 8 RMP (SR) 11 Other (Specify) .....  
 2 Brass 4 Galvanized Steel 6 Concrete tile 9 ABS 12 None used (open hole)  
 SCREEN OR PERFORATION OPENINGS ARE: 5 Gauzed wrapped 8 Saw cut 11 None (open hole)  
 1 Continuous slot 3 Mill slot 6 Wire wrapped 9 Drilled holes  
 2 Louvered shutter 4 Key punched 7 Torch cut 10 Other (specify) ..... ft.  
 SCREEN-PERFORATED INTERVALS: From 31 ft. to 41 ft., From ..... ft. to ..... ft.  
 From 07 ft. to 77 ft., From ..... ft. to ..... ft.  
 GRAVEL PACK INTERVALS: From 79 ft. to 77.4 ft., From ..... ft. to ..... ft.  
 From ..... ft. to ..... ft., From ..... ft. to ..... ft.

6 GROUT MATERIAL: 1 Neat cement 2 Cement grout 3 Bentonite 4 Other .....  
 Grout Intervals: From 0 ft. to 17.4 ft., From ..... ft. to ..... ft., From ..... ft. to ..... ft.  
 What is the nearest source of possible contamination:  
 1 Septic tank 4 Lateral lines 7 Pit privy 10 Livestock pens 14 Abandoned water well  
 2 Sewer lines 5 Cess pool 8 Sewage lagoon 11 Fuel storage 15 Oil well/Gas well  
 3 Watertight sewer lines 6 Seepage pit 9 Feedyard 12 Fertilizer storage 16 Other (specify below)  
 13 Insecticide storage .....  
 Direction from well? Southeast How many feet? 200

FROM	TO	LITHOLOGIC LOG	FROM	TO	PLUGGING INTERVALS
0	17	Brown-Yellow Clay	55	58	Grey Limestone
17	19	Grey Clay	58	82.5	Grey Shale
19	20.5	Silty Sandy Yellow Clay			
20.5	26	Silty Sandy Grey-Yellow Clay			
26	30	Grey Clay			
30	33	Sandy Grey Clay			Shallow grout approval by Don Taylor on 8-22-05
33	35	Fine Grey Sand			
35	39	Cemented Grey Sand			
39	41	Grey Limestone			
41	41.5	Grey Shale			
41.5	42	Coal			
42	52	Grey Shale			
52	54.5	Sandy Grey Shale			
54.5	55	Blue Shale			

7 CONTRACTOR'S OR LANDOWNER'S CERTIFICATION: This water well was (1) constructed, (2) reconstructed, or (3) plugged under my jurisdiction and was completed on (mo/day/year) 8-22-05 and this record is true to the best of my knowledge and belief. Kansas  
 Water Well Contractor's Licence No 739 This Water Well Record was completed on (mo/day/yr) 9-1-05  
 under the business name of Rock Drilling by (signature) Mike Rock