

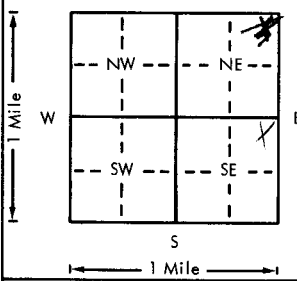
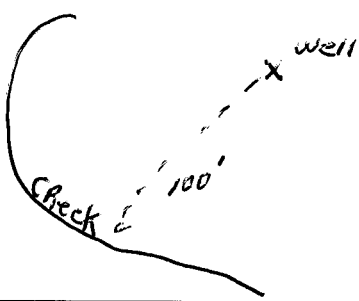
USE TYPEWRITER OR BALL
POINT PEN, PRESS FIRMLY,
PRINT CLEARLY.

DAA

WATER WELL RECORD
KSA 82a-1201-1215

Kansas Department of Health and
Environment-Division of Environment
(Water well Contractors)
Topeka, Kansas 66620

NE NE SE

1. Location of well: County BROWN		Fraction NE NE NE NE SW 1/4 SW 1/4 1/4	Section number 21	Township number T 4	Range number S R 17
2. Distance and direction from nearest town or city: 1 W - 1.5 N		3. Owner of well: MRS KNUDSON			
Street address of well location if in city: OF HORTON		City, state, zip code: HORTON			
4. Locate with "X" in section below: 		Sketch map: 		6. Bore hole dia. 8 in. Completion date 2-29-77 Well depth 100 ft.	
5. Type and color of material		From	To	7. <input checked="" type="checkbox"/> Cable tool <input checked="" type="checkbox"/> Rotary <input type="checkbox"/> Driven <input type="checkbox"/> Dug <input type="checkbox"/> Hollow rod <input type="checkbox"/> Jetted <input type="checkbox"/> Bored <input type="checkbox"/> Reverse rotary	
TOP SOIL		0	4	8. Use: <input checked="" type="checkbox"/> Domestic <input type="checkbox"/> Public supply <input type="checkbox"/> Industry <input type="checkbox"/> Irrigation <input type="checkbox"/> Air conditioning <input checked="" type="checkbox"/> Stock <input type="checkbox"/> Lawn <input type="checkbox"/> Oil field water <input type="checkbox"/> Other	
CLAY, BROWN, SANDY		4	27	9. Casing: Material PVC Height: Above or below Threaded <input type="checkbox"/> Welded <input type="checkbox"/> Surface 24 in. RMP <input type="checkbox"/> PVC 91 Weight 258 lbs./ft. Dia. 5 in. to 100 ft. depth Wall Thickness: inches or Dia. <input type="checkbox"/> in. to <input type="checkbox"/> ft. depth gage No. 3.74	
LIMESTONE, GREY		27	28	10. Screen: Manufacturer's name PUMPSO Type PVC Dia. 5 Slot/gauze 1020 Length 20 Set between 20 ft. and 40 ft. ft. and <input type="checkbox"/> ft. Gravel pack? <input checked="" type="checkbox"/> Size range of material 0.30-0.60	
SHALE, GREY, LIMESTONE, GREY, SHALEY, LIME.		28	100	11. Static water level: <input type="checkbox"/> mo./day/yr. 21 ft. below land surface Date 2-29-77	
				12. Pumping level below land surfaces: ft. after <input type="checkbox"/> hrs. pumping <input type="checkbox"/> g.p.m. ft. after <input type="checkbox"/> hrs. pumping <input type="checkbox"/> g.p.m. Estimated maximum yield 1 g.p.m.	
				13. Water sample submitted: <input type="checkbox"/> mo./day/yr. <input type="checkbox"/> Yes <input checked="" type="checkbox"/> No Date	
				14. Well head completion: CAP <input type="checkbox"/> Pitless adapter 29 inches above grade	
				15. Well grouted? <input checked="" type="checkbox"/> With: <input checked="" type="checkbox"/> Neat cement <input type="checkbox"/> Bentonite <input type="checkbox"/> Concrete Depth: From 3 ft. to 15 ft.	
				16. Nearest source of possible contamination: ft. 100 Direction SW Type DRAINAGE Well disinfected upon completion? <input checked="" type="checkbox"/> Yes <input type="checkbox"/> No	
				17. Pump: <input checked="" type="checkbox"/> Not installed Manufacturer's name Model number <input type="checkbox"/> HP <input type="checkbox"/> Volts <input type="checkbox"/> Length of drop pipe <input type="checkbox"/> ft. capacity <input type="checkbox"/> g.p.m. Type: <input type="checkbox"/> Submersible <input type="checkbox"/> Turbine <input type="checkbox"/> Jet <input type="checkbox"/> Reciprocating <input type="checkbox"/> Centrifugal <input type="checkbox"/> Other	
18. Elevation: 1060 Topography: <input type="checkbox"/> Hill <input checked="" type="checkbox"/> Slope <input type="checkbox"/> Upland <input type="checkbox"/> Valley		19. Remarks: OWNER WILL INSTAL SIAB		20. Water well contractor's certification: This well was drilled under my jurisdiction and this report is true to the best of my knowledge and belief. STANLEY DALL CO INC 182 Business name License No. Address RR # 1 HORTON, KS Signed Jay Johnson Date 2-29-77 Authorized representative	

BR = 1033

Σ = 1039