


1 LOCATION OF WATER WELL: County: **BROWN** Fraction: **SW 1/4 NW 1/4 SW 1/4** Section Number: **28** Township Number: **T 4 S** Range Number: **R 17 EW**

Distance and direction from nearest town or city street address of well if located within city?  
**1712 CENTRAL - HORTON**

2 WATER WELL OWNER: **BROWN-ATCHISON-REC**  
 RR#, St. Address, Box #: **1712 CENTRAL RD BDX 23**  
 City, State, ZIP Code: **HORTON KS 66439**  
 Board of Agriculture, Division of Water Resources  
 Application Number:

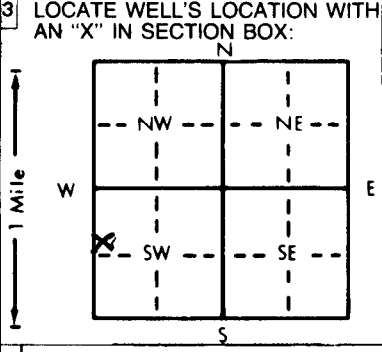

4 DEPTH OF COMPLETED WELL: **26.5** ft. ELEVATION:  
 Depth(s) Groundwater Encountered 1. **20.7** ft. 2. - ft. 3. - ft.  
 WELL'S STATIC WATER LEVEL: **22.71** ft. below land surface measured on mo/day/yr **11-10-94**  
 Pump test data: Well water was - ft. after - hours pumping - gpm  
 Est. Yield - gpm: Well water was - ft. after - hours pumping - gpm  
 Bore Hole Diameter: **8.375** in. to - ft., and - in. to - ft.  
 WELL WATER TO BE USED AS:  
 5 Public water supply 8 Air conditioning 11 Injection well  
 1 Domestic 3 Feedlot 6 Oil field water supply 9 Dewatering 12 Other (Specify below)  
 2 Irrigation 4 Industrial 7 Lawn and garden only 10 Monitoring well  
 Was a chemical/bacteriological sample submitted to Department? Yes - No ; If yes, mo/day/yr sample was submitted -  
 Water Well Disinfected? Yes - No

5 TYPE OF BLANK CASING USED:  
 1 Steel 3 RMP (SR) 5 Wrought iron 8 Concrete tile CASING JOINTS: Glued - Clamped -  
 2 PVC 4 ABS 6 Asbestos-Cement 9 Other (specify below) Welded -  
 7 Fiberglass Threaded   
 Blank casing diameter: **2** in. to **16.5** ft., Dia - in. to - ft., Dia - in. to - ft.  
 Casing height above land surface: **24** in., weight **SCH 40** lbs./ft. Wall thickness or gauge No. -

TYPE OF SCREEN OR PERFORATION MATERIAL:  
 1 Steel 3 Stainless steel 5 Fiberglass 7 PVC 10 Asbestos-cement  
 2 Brass 4 Galvanized steel 6 Concrete tile 8 RMP (SR) 11 Other (specify) -  
 9 ABS 12 None used (open hole)

SCREEN OR PERFORATION OPENINGS ARE:  
 1 Continuous slot 3 Mill slot 5 Gauzed wrapped 8 Saw cut 11 None (open hole)  
 2 Louvered shutter 4 Key punched 6 Wire wrapped 9 Drilled holes  
 7 Torch cut 10 Other (specify) -

SCREEN-PERFORATED INTERVALS: From **16.5** ft. to **26.5** ft., From - ft. to - ft.  
 From - ft. to - ft., From - ft. to - ft.  
~~GRAVEL~~ SAND GRAVEL PACK INTERVALS: From **15.5** ft. to **26.5** ft., From - ft. to - ft.  
 From - ft. to - ft., From - ft. to - ft.

6 GROUT MATERIAL: 1 Neat cement 2 Cement grout 3 Bentonite 4 Other -  
 Grout Intervals: From **0** ft. to **13.5** ft., From **13.5** ft. to **15.5** ft., From - ft. to - ft.  
 What is the nearest source of possible contamination:  
 1 Septic tank 4 Lateral lines 7 Pit privy 10 Livestock pens 14 Abandoned water well  
 2 Sewer lines 5 Cess pool 8 Sewage lagoon 11 Fuel storage 15 Oil well/Gas well  
 3 Watertight sewer lines 6 Seepage pit 9 Feedyard 12 Fertilizer storage 16 Other (specify below)  
 13 Insecticide storage **VERY CONTAMINATED SITE**  
 Direction from well? **L** How many feet? **1**

FROM	TO	LITHOLOGIC LOG	FROM	TO	PLUGGING INTERVALS
0	3	SOIL-CLAY SILT			
3	10	CLAY SILT			
10	15	CLAY SILT-GRAY / BR			
15	26.5	SANDY CLAY WITH LENSES OF SAND			
26.5	TD	-			

7 CONTRACTOR'S OR LANDOWNER'S CERTIFICATION: This water well was (1) constructed, (2) reconstructed, or (3) plugged under my jurisdiction and was completed on (mo/day/year) **11-07-94** and this record is true to the best of my knowledge and belief. Kansas Water Well Contractor's License No. **479** This Water Well Record was completed on (mo/day/yr) **11-14-94** under the business name of **EBBERTS DRILLING** by (signature) *Gregory M. Ebberts*