


1 LOCATION OF WATER WELL: County: BROWN Fraction: NW 1/4 NW 1/4 Section Number: 21 Township Number: T 4 S Range Number: R 18 E/W

Distance and direction from nearest town or city street address of well if located within city?
1/2 M EAST - 2 Mi North of EVEREST

2 WATER WELL OWNER: WELDON QUILLICKSON
 RR#, St. Address, Box #: _____ City, State, ZIP Code: EVEREST, KANSAS
 Board of Agriculture, Division of Water Resources Application Number: _____

3 LOCATE WELL'S LOCATION WITH AN "X" IN SECTION BOX:

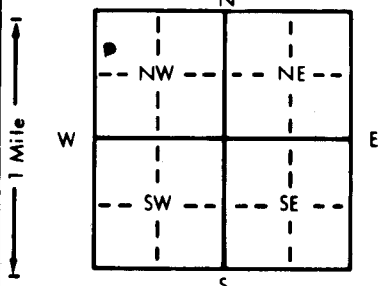

4 DEPTH OF COMPLETED WELL: 82 ft. ELEVATION: _____

Depth(s) Groundwater Encountered 1. 38 ft. 2. _____ ft. 3. _____ ft.

WELL'S STATIC WATER LEVEL: 26 ft. below land surface measured on mo/day/yr

Pump test data: Well water was _____ ft. after _____ hours pumping _____ gpm

Est. Yield 4 gpm: Well water was _____ ft. after _____ hours pumping _____ gpm

Bore Hole Diameter: 10 in. to 15 in., and 8 1/4 in. to 8 2 in.

WELL WATER TO BE USED AS: 5 Public water supply 8 Air conditioning 11 Injection well

1 Domestic 3 Feedlot 6 Oil field water supply 9 Dewatering 12 Other (Specify below)

2 Irrigation 4 Industrial 7 Lawn and garden only 10 Observation well

Was a chemical/bacteriological sample submitted to Department? Yes _____ No If yes, mo/day/yr sample was submitted _____

Water Well Disinfected? Yes No _____

5 TYPE OF BLANK CASING USED: 5 Wrought iron 8 Concrete tile CASING JOINTS: Glued Clamped _____

1 Steel 3 RMP (SR) 6 Asbestos-Cement 9 Other (specify below) Welded _____

2 PVC 4 ABS 7 Fiberglass Threaded _____

Blank casing diameter: 6 in. to 8 1/2 ft., Dia _____ in. to _____ ft., Dia _____ in. to _____ ft.

Casing height above land surface: 18 in., weight _____ lbs./ft. Wall thickness or gauge No. 0.255

TYPE OF SCREEN OR PERFORATION MATERIAL: 7 PVC 10 Asbestos-cement

1 Steel 3 Stainless steel 5 Fiberglass 8 RMP (SR) 11 Other (specify) _____

2 Brass 4 Galvanized steel 6 Concrete tile 9 ABS 12 None used (open hole)

SCREEN OR PERFORATION OPENINGS ARE: 5 Gauzed wrapped 8 Saw cut 11 None (open hole)

1 Continuous slot 3 Mill slot 6 Wire wrapped 9 Drilled holes

2 Louvered shutter 4 Key punched 7 Torch cut 10 Other (specify) _____

SCREEN-PERFORATED INTERVALS: From 35 ft. to 55 ft., From 65 ft. to 82 ft.

GRAVEL PACK INTERVALS: From 15 ft. to 82 ft., From _____ ft. to _____ ft.

6 GROUT MATERIAL: 1 Neat cement 2 Cement grout 3 Bentonite 4 Other _____

Grout Intervals: From 4 ft. to 15 ft., From _____ ft. to _____ ft.

What is the nearest source of possible contamination: OLD Livestock pens 14 Abandoned water well

1 Septic tank 4 Lateral lines 7 Pit privy 11 Fuel storage 15 Oil well/Gas well

2 Sewer lines 5 Cess pool 8 Sewage lagoon 12 Fertilizer storage 16 Other (specify below)

3 Watertight sewer lines 6 Seepage pit 9 Feedyard 13 Insecticide storage

Direction from well? _____ How many feet? 300 FT North

FROM	TO	LITHOLOGIC LOG	FROM	TO	LITHOLOGIC LOG
0	3	TOP SOIL			
3	15	Yellow CLAY			
15	34	SANDY Yellow CLAY			
34	35	SAND - GRAVEL			
35	42	Limestone			
42	56	Blue CLAY			
56	62	Limestone			
62	80	Blue SHALE			
80	82	BLACK SLATE			

7 CONTRACTOR'S OR LANDOWNER'S CERTIFICATION: This water well was (1) constructed, (2) reconstructed, or (3) plugged under my jurisdiction and was completed on (mo/day/year) 11-12-82 and this record is true to the best of my knowledge and belief. Kansas

Water Well Contractor's License No. 317 This Water Well Record was completed on (mo/day/yr) 1-4-83

under the business name of WILLIAMSON Well DRIG by (signature) Francis Kramer

INSTRUCTIONS: Use typewriter or ball point pen, PLEASE PRESS FIRMLY and PRINT clearly. Please fill in blanks, underline or circle the correct answers. Send top three copies to Kansas Department of Health and Environment, Division of Environment, Environmental Geology Section, Topeka, KS 66620. Send one to WATER WELL OWNER and retain one for your records.