

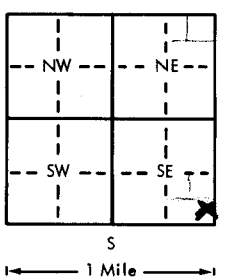
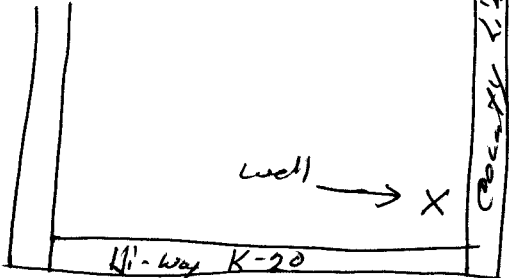
USE TYPEWRITER OR BALL
POINT PEN-PRESS FIRMLY,
PRINT CLEARLY.

WATER WELL RECORD
KSA 82a-1201-1215

Kansas Department of Health and
Environment-Division of Environment
(Water well Contractors)
Topeka, Kansas 66620

DDD

24

1. Location of well:		County <u>Barton</u>	Fraction <u>SE 1/4 SE 1/4 SE 1/4</u>	Section number <u>24</u>	Township number <u>T 4</u>	Range number <u>S 18 E 18</u>
2. Distance and direction from nearest town or city: <u>1/2 mi. W</u>		3. Owner of well: <u>Heinen</u> R.R. or street: <u>RR</u> City, state, zip code: <u>Huron, Ks. 66038</u>				
4. Locate with "X" in section below:		Sketch map:				
						
5. Type and color of material		From	To	6. Bore hole dia. <u>10 1/2</u> in. Completion date <u>5-26-77</u> Well depth <u>1053</u> ft.		
<u>Top Soil</u>		<u>0</u>	<u>4</u>	7. <input checked="" type="checkbox"/> Cable tool <input checked="" type="checkbox"/> Rotary <input type="checkbox"/> Driven <input type="checkbox"/> Dug <input type="checkbox"/> Hollow rod <input type="checkbox"/> Jetted <input type="checkbox"/> Bored <input type="checkbox"/> Reverse rotary		
<u>Brown Clay</u>		<u>4</u>	<u>5</u>	8. Use: <input checked="" type="checkbox"/> Domestic <input type="checkbox"/> Public supply <input type="checkbox"/> Industry <input type="checkbox"/> Irrigation <input type="checkbox"/> Air conditioning <input type="checkbox"/> Stock <input type="checkbox"/> Lawn <input type="checkbox"/> Oil field water <input type="checkbox"/> Other		
<u>Brown Fine sandy Clay</u>		<u>5</u>	<u>15</u>	9. Casing: Material <u>PVC</u> Height: <u>Above</u> or below Threaded <input type="checkbox"/> Welded <input type="checkbox"/> Surface <u>24</u> in. RMP <input type="checkbox"/> PVC <u>Blue</u> Weight <u>2.74</u> lbs./ft. Dia. <u>5</u> in. to <u>10 1/2</u> ft. depth Wall Thickness: inches or Dia. <u>5</u> in. to <u>10 1/2</u> ft. depth gage No. <u>258</u>		
<u>Gray Clay</u>		<u>15</u>	<u>16</u>	10. Screen: Manufacturer's name <u>Pumpro</u> Type <u>PVC</u> Dia. <u>5</u> in. Slot/gauze <u>1020</u> Length <u>10</u> ft. Set between <u>32</u> ft. and <u>42</u> ft. Gravel pack? <u>Yes</u> Size range of material <u>030/108</u>		
<u>Brown Fine Sandy Clay</u>		<u>16</u>	<u>17</u>	11. Static water level: <u>15</u> ft. below land surface Date <u>5-26-77</u> mo./day/yr.		
<u>Gray Sandy Clay</u>		<u>17</u>	<u>21</u>	12. Pumping level below land surfaces: <u>11 1/2</u> ft. ft. after <u> </u> hrs. pumping <u> </u> g.p.m. ft. after <u> </u> hrs. pumping <u> </u> g.p.m. Estimated maximum yield <u>30</u> g.p.m.		
<u>Gray Clay</u>		<u>21</u>	<u>27</u>	13. Water sample submitted: <u> </u> mo./day/yr. Yes <input checked="" type="checkbox"/> No <input type="checkbox"/> Date <u> </u>		
<u>Gray Fine Sand</u>		<u>27</u>	<u>30</u>	14. Well head completion: <u>Top Cap</u> <u> </u> Pitless adapter <u>24</u> inches above grade		
<u>Gray & White Coarse to Med Gravel</u>		<u>30</u>	<u>41</u>	15. Well grouted? <u>Yes</u> With: <input checked="" type="checkbox"/> Neat cement <input type="checkbox"/> Bentonite <input type="checkbox"/> Concrete Depth: From <u>5</u> ft. to <u>15</u> ft.		
<u>Gray Clay</u>		<u>41</u>	<u>48</u>	16. Nearest source of possible contamination: <u>#19</u> ft. <u> </u> Direction <u> </u> Type <u> </u> Well disinfected upon completion? <input checked="" type="checkbox"/> Yes <input type="checkbox"/> No		
<u>Gray Shale</u>		<u>48</u>	<u>60</u>	17. Pump: <input checked="" type="checkbox"/> Not installed Manufacturer's name <u> </u> Model number <u> </u> HP <u> </u> Volts <u> </u> Length of drop pipe <u> </u> ft. capacity <u> </u> g.p.m. Type: <input type="checkbox"/> Submersible <input type="checkbox"/> Turbine <input type="checkbox"/> Jet <input type="checkbox"/> Reciprocating <input type="checkbox"/> Centrifugal <input type="checkbox"/> Other		
18. Elevation: <u>1100'</u> Topography: <input checked="" type="checkbox"/> Hill <input checked="" type="checkbox"/> Slope <input type="checkbox"/> Upland <input type="checkbox"/> Valley		19. Remarks: <u>owner will construct cement slab around well</u> <u>#16 - well is pasture for New House site</u>		20. Water well contractor's certification: This well was drilled under my jurisdiction and this report is true to the best of my knowledge and belief. <u>Strader Drilling Co Inc</u> License No. <u>182</u> Business name <u>RTI Holton, KS</u> Address <u> </u> Signed <u>Dale Adam</u> Date <u>5-28-77</u> Authorized representative		

Forward the white, blue and pink copies to the Department of Health and Environment

Form WWC-5

BR = 1052 V = 1085