

County: Brown Fraction: \_\_\_\_\_ Sec. 23 T 4 S R 18 W

**CORRECTION(S) TO WATER WELL COMPLETION RECORD (WWC-5)**

(To rectify lacking or incorrect information)

Owner: KDOT

**Location was listed as:**

~~Section-Township-Range:~~ \_\_\_\_\_

~~Fraction (1/4 1/4 1/4):~~ \_\_\_\_\_

**Changed to:**

\_\_\_\_\_  
\_\_\_\_\_

**Other changes: Initial statements:** \_\_\_\_\_

Station # 184+49, 104' LT & K-20

Changed to: \_\_\_\_\_


Comments: KDOT core available for CD4 also

(no paperwork available as of 12/10/2015)

Verification method: \_\_\_\_\_

Submitted by: \_\_\_\_\_ initials: \_\_\_\_\_ date: \_\_\_\_\_

to: Kansas Geological Survey, Data Resources Library, 1930 Constant Ave., Lawrence KS 66047-3726  
to: Kansas Dept of Health & Environment, Bureau of Water, 1000 SW Jackson, Suite 420, Topeka, KS 66612-1367.

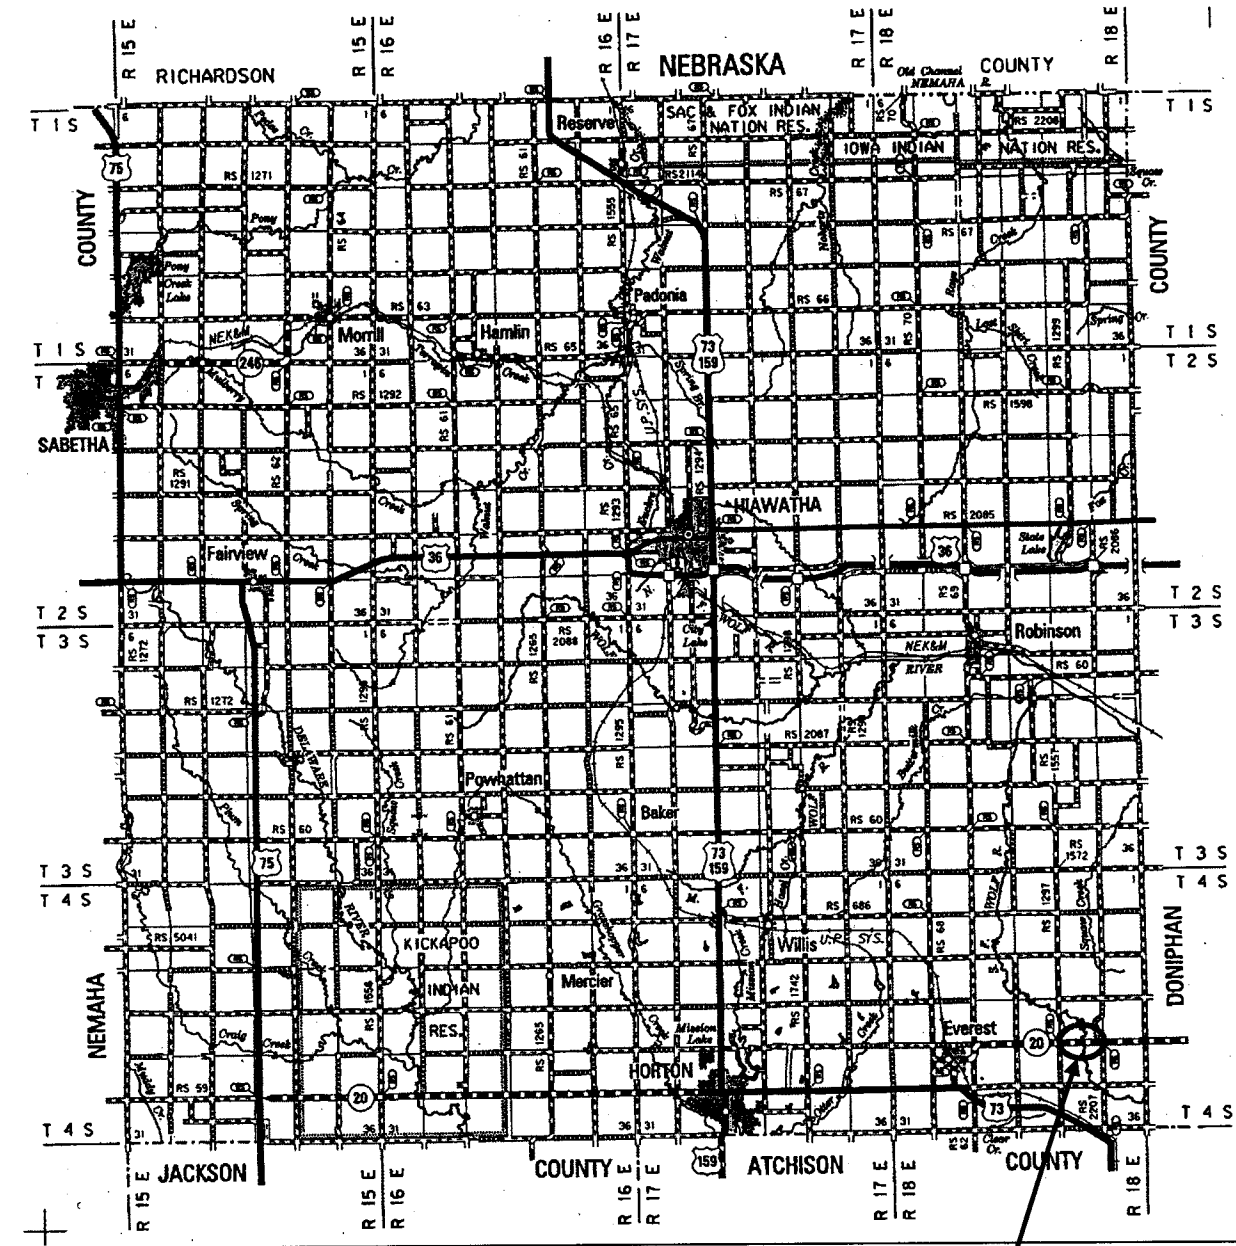

20-7 KA-2054-01 K-20 over South of Fork Wolf Creek

Bridge No. 20-7-20.28(063)

Brown County

CD 02

N: 39.681951 E: -95.368969(Approx.)

SW ¼, SW ¼, SE ¼, Section 23, T04S, R18E