USE TYPEWRITER OR BALL POINT PEN-PRESS FIRMLY, PRINT CLEARLY.

T	R	EW	sec 1/4	1/4	1/4	No.

cab

WATER WELL RECORD
KSA 82a-1201-1215

Kansas State Dept. Of Health
(Water Well Contractors)
Forbes-Bldg. 740
Topeka, Kansas 66620

NW NE SW

1 Location of well: County	Township name	Fraction	Section number	Town number	Range number
Doniphan	Union	~~SW 1/4~~	~~20~~ 7	45	19 E

Distance and direction from nearest town or city:

Street address of well location if in city:

3 Owner of well: Phillip Harrison
Address: Denton, Kans

Locate with "X" in section below:

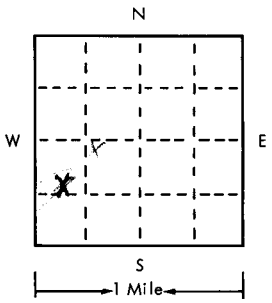

Sketch map:

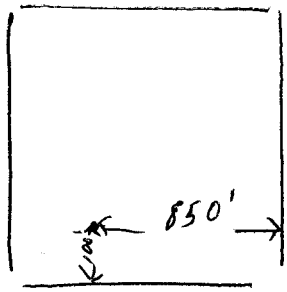

4 Well depth: 70 ft. Date of completion 1-14-75
Well diameter 5 in.

5 ☐ Cable tool ☒ Rotary ☐ Driven ☐ Dug
☐ Hollow rod ☐ Jetted ☐ Bored ☐ Reverse rotary

6 Use: ☒ Domestic ☐ Public supply ☐ Industry
☐ Irrigation ☐ Air conditioning ☐ Commercial
☐ Test well ☐

7 Casing: Material PVC Height: above/below
Threaded ☐ Welded ☐ Surface 24 in.
Diam. 5" Weight 2.33 lbs./ft.
0 in. to 70 ft. depth Drive shoe? ☐ Yes ☒ No
___ in. to ___ ft. depth

2

Type and color of material	From	To
TOP SOIL	0	4
BROWN CLAY	4	40
BLUE CLAY	40	50
COURSE SAND	50	68
BLUE SHALE	68	70
(use a second sheet if needed)		

8 Screen:
Manufacturer Pumpco
Type PVC Dia. 5"
Slot/~~gauze~~ .030 Length 8'
Set between 60 ft. and 68 ft.
Fittings:
Gravel pack ☒ Yes ☐ No Size range of material #2

9 Static water level:
18 ft. below land surface Date 1-14-75

10 Pumping level below land surface: AIR TEST
___ ft. after ___ hrs. pumping ___ g.p.m.
___ ft. after ___ hrs. pumping ___ g.p.m.
Estimated maximum yield 15 g.p.m.

11 Water sample submitted:
☐ Yes ☒ No Date ___

12 Well head completion:
☒ Pitless adapter 24" ☒ Inches above grade

13 Well grouted? ☒ Yes ☐ No
☒ Neat cement ☐ Bentonite ☐ ___
Depth: From 0 ft. to 10 ft.

14 Nearest source of possible contamination:
ft. 200 Direction EAST Type SEPTIC TANK
Well disinfected upon completion? ☒ Yes ☐ No

15 Pump: ☒ Not installed
Manufacturer's name ___
Model number ___ HP ___ Volts ___
Length of drop pipe ___ ft. capacity ___ g.m.p.
Type:
☐ Submersible ☐ Turbine
☐ Jet ☐ Reciprocating
☐ Certrifugal ☐ Other

16 Remarks: elevation
~~1120~~ 2-6'

Topography:
☒ Hill
☐ Slope
☐ Upland
☐ Valley

17 Water well contractor's certification:
This well was drilled under my jurisdiction and this report is true to the best of my knowledge and belief.
Business name Strader Drilling Co. Inc. License No. #182
Address RI-75N Holton, KANS.
Signed [signature] Date 1-18-75
Authorized representative

Forward the white, blue and pink copies to the Kansas State Dept. Of Health.

Form WWC-5