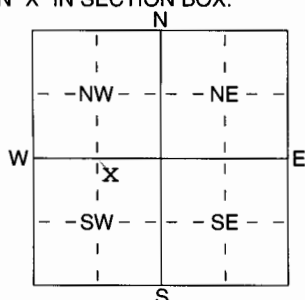


1 LOCATION OF WATER WELL:	Fraction	Section Number	Township Number	Range Number
County: <b>Doniphan</b>	<b>NW ¼ NE ¼ SW ¼</b>	<b>28</b>	<b>T 4 S</b>	<b>R 19E E/W</b>

Distance and direction from nearest town or city street address of well if located within city?

**3 1/2 miles south and 1 1/4 miles west of Denton**2 WATER WELL OWNER: **Scholz Farm, Inc.**RR#, St. Address, Box # : **Ron & Mariam Scholz****66087** Board of Agriculture, Division of Water ResourcesCity, State, ZIP Code : **961 XX Chalk Bluff Rd , Severence, Ks. 66087** Location Number:3 LOCATE WELL'S LOCATION WITH AN "X" IN SECTION BOX: 4 DEPTH OF COMPLETED WELL ..... **120** ..... ft. ELEVATION: .....

Depth(s) Groundwater Encountered 1 ..... ft. 2 ..... ft. 3 ..... ft.  
 WELL'S STATIC WATER LEVEL ..... **39** ..... ft. below land surface measured on mo/day/yr ..... **11-7-05** .....  
 Pump test data: Well water was ..... ft. after ..... hours pumping ..... gpm  
 Est. Yield ..... **1.2** ..... gpm: Well water was ..... ft. after ..... hours pumping ..... gpm  
 WELL WATER TO BE USED AS: 5 Public water supply 8 Air conditioning 11 Injection well  
 1 Domestic 3 Feedlot 6 Oil field water supply 9 Dewatering 12 Other (Specify below)  
 2 Irrigation 4 Industrial 7 Domestic (lawn & garden) 10 Monitoring well .....

Was a chemical/bacteriological sample submitted to Department? Yes ..... No ..... **X** ..... ; If yes, mo/day/yr sample was submitted  
 Water Well Disinfected? Yes **X X** No

5 TYPE OF BLANK CASING USED: 5 Wrought iron 8 Concrete tile CASING JOINTS: Glued **X** Clamped .....

1 Steel 3 RMP (SR) 6 Asbestos-Cement 9 Other (specify below) Welded .....  
 2 PVC 4 ABS 7 Fiberglass Threaded .....

Blank casing diameter ..... **5** ..... in. to ..... ft., Dia ..... in. to ..... ft., Dia ..... in. to ..... ft.Casing height above land surface ..... **24** ..... in., weight ..... **2.82** ..... lbs./ft. Wall thickness or gauge No. **258**

TYPE OF SCREEN OR PERFORATION MATERIAL:

1 Steel 3 Stainless Steel 5 Fiberglass 7 PVC 10 Asbestos-Cement  
 2 Brass 4 Galvanized Steel 6 Concrete tile 8 RMP (SR) 11 Other (Specify) .....  
 12 None used (open hole)

SCREEN OR PERFORATION OPENINGS ARE:

1 Continuous slot 3 Mill slot 5 Guazed wrapped 8 Saw cut 11 None (open hole)  
 2 Louvered shutter 4 Key punched 6 Wire wrapped 9 Drilled holes  
 7 Torch cut 10 Other (specify) .....

SCREEN-PERFORATED INTERVALS: From ..... **42** ..... ft. to ..... **72** ..... ft., From ..... **104** ..... ft. to ..... **114** ..... ft.GRAVEL PACK INTERVALS: From ..... **25** ..... ft. to ..... **120** ..... ft., From ..... ft. to ..... ft.

6 GROUT MATERIAL: 1 Neat cement 2 Cement grout 3 Bentonite 4 Other .....

Grout Intervals: From ..... **3** ..... ft. to ..... **25** ..... ft., From ..... ft. to ..... ft., From ..... ft. to ..... ft.

What is the nearest source of possible contamination:

1 Septic tank 4 Lateral lines 7 Pit privy 10 Livestock pens 14 Abandoned water well  
 2 Sewer lines 5 Cess pool 8 Sewage lagoon 11 Fuel storage 15 Oil well/Gas well  
 3 Watertight sewer lines 6 Seepage pit 9 Feedyard 12 Fertilizer storage 16 Other (specify below)  
**ditch**

Direction from well? **north** How many feet? **100'**

FROM	TO	LITHOLOGIC LOG	FROM	TO	PLUGGING INTERVALS
0	1	top soil	105	113	shale grey
1	13	clay brown	113	115	limestone grey
13	17	clay brown sandy	115	120	shale grey
17	23	fine sand brown			
23	34	clay tan silty			
34	55	fine sand brown			
55	59	clay brown sandy			
59	63	fine sand brown			
63	65	clay grey			
65	72	fine sand brown			
72	83	clay grey			
83	103	shale grey			
103	105	limestone grey			

7 CONTRACTOR'S OR LANDOWNER'S CERTIFICATION: This water well was (1) constructed, (2) reconstructed, or (3) plugged under my jurisdiction and was completed on (mo/day/year) ..... **11-7-05** ..... and this record is true to the best of my knowledge and belief. Kansas Water Well Contractor's Licence No ..... **182** ..... This Water Well Record was completed on (mo/day/yr) ..... **12-29-05** ..... under the business name of **Strader Drilling Co., Inc.** by (signature) *Jim Strader*