

CORRECTION TO WATER WELL RECORD (WWC-5)

The following correction(s) was made to the attached WWC-5 log, in order to file the item or to rectify lacking or incorrect information.

Fraction (1/4 1/4 1/4) Section-Township-Range changed:

listed as 31-4-2

changed to SE SE SE, 31-45-2E

Other changes: Initial statements: Linn is 8 miles west and 2 miles south.

Changed to: 8 miles west and 2 miles south of Linn.

Comments: _____


verification method: Legal & written descriptions, position on plat map, and
Linn, Palmer, & Greenleaf 1:24,000 topo maps. initials: WRP date: 7/18/2000

submitted by: Kansas Geological Survey, Data Resources Library, 1930 Constant Ave., Lawrence, KS 66047-3726
to: Kansas Dept of Health & Environment Bureau of Water Industrial Programs, Bldg 283, Forbes Field, KS 66620

1	LOCATION OF WATER WELL: County: <u>Washington</u>	Fraction <u>1/4 1/4 1/4</u>	Section Number <u>31</u>	Township Number <u>4</u>	Range Number <u>2</u>
---	--	--------------------------------	-----------------------------	-----------------------------	--------------------------

Distance and direction from nearest town or city street address of well if located within city?
Linn is 8 miles west and 2 miles south

2 WATER WELL OWNER: Barbara Reith
 RR#, St. Address, Box #: 826 8th Rd Board of Agriculture, Division of Water Resources
 City, State, ZIP Code : Linn, Ks 66953 Application Number:

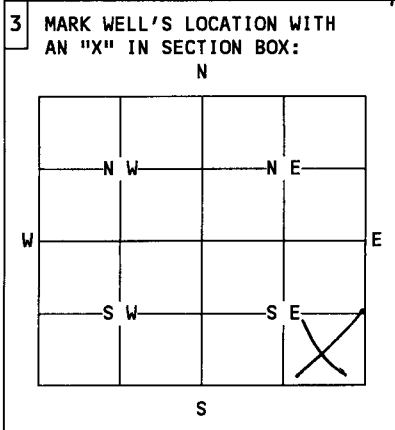

4 DEPTH OF WELL.....29.....ft.
 WELL'S STATIC WATER LEVEL No. H₂O.....ft.
 WELL WAS USED AS:
 1 Domestic 5 Public Water Supply 9 Dewatering
 2 Irrigation 6 Oil Field Water Supply 10 Monitoring Well
 3 Feedlot 7 Lawn and Garden Only 11 Injection Well
 4 Industrial 8 Air Conditioning 12 Other.....
 Was a chemical/bacteriological sample submitted to Department? Yes....No.
 If yes, mo/day/yr sample was submitted.....
 Water Well Disinfected: Yes..... No.

5 TYPE OF BLANK CASING USED:
 1 Steel 3 RMP (SR) 5 Wrought 7 Fiberglass 9 Other (specify below)
 2 PVC 4 ABS 6 Asbestos-Cement 8 Concrete Tile

Blank casing diameter.....6.....in. Was casing pulled? Yes... No..... If yes, how much...6'
 Casing height above or below land surface.....7.2.....in.

6 GROUT PLUG MATERIAL: 1 Neat cement 2 Cement grout 3 Bentonite 4 Other.....
 Grout Plug Intervals: From 4.5 ft. to 5.0 ft., From.....ft. toft., From..... to.....ft.
 What is the nearest source of possible contamination:
 1 Septic tank 6 Seepage pit 11 Fuel storage 16 Other (specify below)
 2 Sewer lines 7 Pit privy 12 Fertilizer storage ...Crop field.....
 3 Watertight sewer lines 8 Sewage lagoon 13 Insecticide storage
 4 Lateral lines 9 Feedyard 14 Abandoned water well
 5 Cess Pool 10 Livestock pens 15 Oil well/Gas well
 Direction from well? all sides..... How many feet? immediately.

FROM	TO	PLUGGING MATERIALS
<u>0</u>	<u>4.5</u>	<u>Topsoil</u>
<u>4.5</u>	<u>5.0</u>	<u>Bentonite Plug</u>
<u>5.0</u>	<u>29</u>	<u>Clay Soil</u>

No Chlorine or Sand was needed since no water was in the well.

7 CONTRACTOR'S OR LANDOWNER'S CERTIFICATION: This water well was plugged under my jurisdiction and was completed on (mo/day/year).....6-2-00..... and this record is true to the best of my knowledge and belief. Kansas Water Well Contractor's License No.NA..... This Water Well Record was completed on (mo/day/year).....6-2-00..... under the business name of Washington Co. Conservation District by (signature) Nina Muya, NPS Coordinator.....

INSTRUCTIONS: Use typewriter or ball point pen. Please press firmly and print clearly. Please fill in blanks, underline or circle the correct answers. Send top three copies to Kansas Department of Health and Environment, Bureau of Water, Topeka, Kansas 66620-0001. Telephone: 913/296-3565. Send one to Water Well Owner and retain one for your records.