

LOCATION OF WATER WELL County: WASHINGTON	Fraction SW 1/4 SW 1/4 NW 1/4	Section Number 35	Township Number T 4 S	Range Number R 2 E
---	---	-----------------------------	---------------------------------	------------------------------

Distance and direction from nearest town or city? **1 WEST**
3 N PALMER
 Street address of well if located within city?

WATER WELL OWNER:
WALTER A. HARTMAN
 R#, St. Address, Box #: **CLAY CENTER, KANSAS 67432**
 City, State, ZIP Code: **CLAY CENTER, KANSAS 67432**
 Board of Agriculture, Division of Water Resources
 Application Number:

DEPTH OF COMPLETED WELL: **120** ft. Bore Hole Diameter: **8** in. to ft., and in. to ft.

Well Water to be used as:
 1 Domestic 3 Feedlot 5 Public water supply 8 Air conditioning 11 Injection well
 2 Irrigation 4 Industrial 6 Oil field water supply 9 Dewatering 12 Other (Specify below)
 7 Lawn and garden only 10 Observation well

Well's static water level: **52** ft. below land surface measured on **5** month **30** day **80** year
 Pump Test Data: Well water was ft. after hours pumping gpm
 Static Yield: **60** gpm: Well water was ft. after hours pumping gpm

TYPE OF BLANK CASING USED:
 1 Steel 3 RMP (SR) 5 Wrought iron 8 Concrete tile Casing Joints: Glued Clamped
 PVC 4 ABS 7 Fiberglass 9 Other (specify below) Welded
 Threaded

Blank casing dia: **5** in. to **100** ft., Dia in. to ft., Dia in. to ft.
 Casing height above land surface: **12** in., weight **3** lbs./ft. Wall thickness or gauge No. **258**

TYPE OF SCREEN OR PERFORATION MATERIAL:
 1 Steel 3 Stainless steel 5 Fiberglass 8 RMP (SR) 10 Asbestos-cement
 2 Brass 4 Galvanized steel 6 Concrete tile 9 ABS 11 Other (specify)
 12 None used (open hole)

Screen or Perforation Openings Are:
 1 Continuous slot 3 Mill slot 5 Gauzed wrapped 8 Saw cut 11 None (open hole)
 2 Louvered shutter 4 Key punched 6 Wire wrapped 9 Drilled holes
 7 Torch cut 10 Other (specify)

Screen-Perforation Dia: **5** in. to **120** ft., Dia in. to ft., Dia in. to ft.

Screen-Perforated Intervals: From **100** ft. to **120** ft., From ft. to ft. to ft. to ft.

Gravel Pack Intervals: From **10** ft. to **120** ft., From ft. to ft. to ft. to ft.

GROUT MATERIAL: Neat cement 2 Cement grout 3 Bentonite 4 Other
 Grouted Intervals: From **10** ft. to **10** ft., From ft. to ft. to ft. to ft.

What is the nearest source of possible contamination:
 Septic tank 4 Cess pool 7 Sewage lagoon 10 Fuel storage 14 Abandoned water well
 2 Sewer lines 5 Seepage pit 8 Feed yard 11 Fertilizer storage 15 Oil well/Gas well
 3 Lateral lines 6 Pit privy 9 Livestock pens 12 Insecticide storage 16 Other (specify below)
 13 Watertight sewer lines


Direction from well: **WEST** How many feet: **100** ? Water Well Disinfected? Yes No

Was a chemical/bacteriological sample submitted to Department? Yes No If yes, date sample
 was submitted month day year: Pump Installed? Yes No

Yes: Pump Manufacturer's name Model No. HP Volts
 Depth of Pump Intake ft. Pumps Capacity rated at gal./min.

Type of pump: 1 Submersible 2 Turbine 3 Jet 4 Centrifugal 5 Reciprocating 6 Other

CONTRACTOR'S OR LANDOWNER'S CERTIFICATION: This water well was constructed, (2) reconstructed, or (3) plugged under my jurisdiction and was
 completed on **5** month **30** day **80** year
 and this record is true to the best of my knowledge and belief. Kansas Water Well Contractor's License No. **359**
 This Water Well Record was completed on **5** month **30** day **80** year under the business
 name of **DARYL Cox & Sons Inc** by (signature) **Daryl Cox**

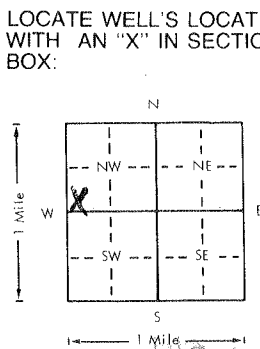

LOCATE WELL'S LOCATION WITH AN "X" IN SECTION BOX:	FROM	TO	LITHOLOGIC LOG	FROM	TO	LITHOLOGIC LOG
	0	3	TOPSOIL			
	3	8	GRAY CLAY			
	8	18	YELLOW CLAY w/ SAND	80	120	ROCK LAYERS
	18	68	SAND ROCK			
	68	95	BLUE CLAY			
	95	120	SAND ROCK			
	120		STOP			

ELEVATION: **1420'**

Depth(s) Groundwater Encountered 1. ft. 2. ft. 3. ft. 4. ft. (Use a second sheet if needed)

INSTRUCTIONS: Use typewriter or ball point pen, please press firmly and PRINT clearly. Please fill in blanks, underline or circle the correct answers. Send top three copies to Kansas Department of Health and Environment, Division of Environment, Water Well Contractors, Topeka, KS 66620. Send one to WATER WELL OWNER and retain one for your records.