


1 LOCATION OF WATER WELL: Fraction $\frac{1}{4}$ $\frac{1}{4}$ $\frac{1}{4}$ Section Number 11 Township Number T 04 S Range Number R 20 E/W

Distance and direction from nearest town or city street address of well if located within city?
 County: Doniphan
 7 MI SOUTH WEST OF TROY KANSAS

2 WATER WELL OWNER: LESTER E. PEUKER
 RR#, St. Address, Box #: Box 16
 City, State, ZIP Code: Bendena, KS. 66008
 Board of Agriculture, Division of Water Resources
 Application Number:

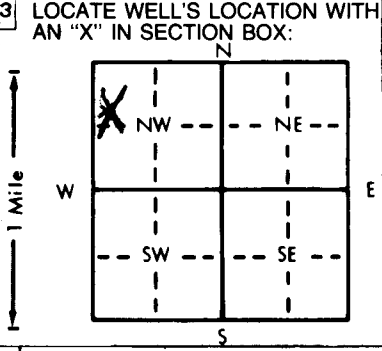

4 DEPTH OF COMPLETED WELL: 67 ft. ELEVATION: ... ft.
 Depth(s) Groundwater Encountered 1. 52 ft. 2. ... ft. 3. ... ft.
 WELL'S STATIC WATER LEVEL 36 ft. below land surface measured on mo/day/yr 8-27-89
 Pump test data: Well water was 60 ft. after 1 1/2 hours pumping 4 gpm
 Est. Yield 2 gpm Well water was ... ft. after ... hours pumping ... gpm
 Bore Hole Diameter 5 1/4 in. to 20 ft., and 4 1/2 in. to 67 ft.
 WELL WATER TO BE USED AS:
 1 Domestic 3 Feedlot 6 Oil field water supply 9 Dewatering 12 Other (Specify below)
 2 Irrigation 4 Industrial 7 Lawn and garden only 10 Monitoring well
 Was a chemical/bacteriological sample submitted to Department? Yes... No. X...; If yes, mo/day/yr sample was submitted
 Water Well Disinfected? es X No

5 TYPE OF BLANK CASING USED:
 1 Steel 3 RMP (SR) 5 Wrought iron 8 Concrete tile CASING JOINTS: Glued ... Clamped ...
 2 PVC 4 ABS 6 Asbestos-Cement 9 Other (specify below) Welded ...
 7 Fiberglass Threaded ...
 Blank casing diameter 36 in. to 67 ft., Dia. ... in. to ... ft., Dia. ... in. to ... ft.
 Casing height above land surface 30 in., weight 3.20 lbs./ft. Wall thickness or gauge No. ...
 TYPE OF SCREEN OR PERFORATION MATERIAL:
 1 Steel 3 Stainless steel 5 Fiberglass 8 RMP (SR) 11 Other (specify) ...
 2 Brass 4 Galvanized steel 6 Concrete tile 9 ABS 12 None used (open hole)
 SCREEN OR PERFORATION OPENINGS ARE:
 1 Continuous slot 3 Mill slot 5 Gauzed wrapped 8 Saw cut 11 None (open hole)
 2 Louvered shutter 4 Key punched 6 Wire wrapped 9 Drilled holes
 7 Torch cut 10 Other (specify) ...
 SCREEN-PERFORATED INTERVALS: From ... ft. to ... ft., From ... ft. to ... ft.
 GRAVEL PACK INTERVALS: From ... ft. to ... ft., From ... ft. to ... ft.

6 GROUT MATERIAL: 1 Neat cement 2 Cement grout 3 Bentonite 4 Other ...
 Grout Intervals: From 0 ft. to 20 ft., From ... ft. to ... ft., From ... ft. to ... ft.
 What is the nearest source of possible contamination:
 1 Septic tank 4 Lateral lines 7 Pit privy 10 Livestock pens 14 Abandoned water well
 2 Sewer lines 5 Cess pool 8 Sewage lagoon 11 Fuel storage 15 Oil well/Gas well
 3 Watertight sewer lines 6 Seepage pit 9 Feedyard 12 Fertilizer storage 16 Other (specify below)
 13 Insecticide storage 400 FT.
 Direction from well? How many feet?

FROM	TO	LITHOLOGIC LOG	FROM	TO	PLUGGING INTERVALS
0	19	BROWN WIND BLOWN			
19	31	YELLOW CLAY			
31	39	SAME WITH CHALK ROCK			
39	52	BLUE CLAY			
52	61	BLUE/GRAY SAND + GRAVEL PRODUCES SOME WATER			
61	67	BLUE CLAY - VERY HARD NEAR SHALE AT 67			

7 CONTRACTOR'S OR LANDOWNER'S CERTIFICATION: This water well was (1) constructed, (2) reconstructed, or (3) plugged under my jurisdiction and was completed on (mo/day/year) 8-27-89 and this record is true to the best of my knowledge and belief. Kansas Water Well Contractor's License No. 320 This Water Well Record was completed on (mo/day/yr) 9-13-89 under the business name of POPPLEWELL WELL BORING by (signature) Jerry Popplewell