


1 LOCATION OF WATER WELL: County: ~~Doniphan~~ **Doniphan** Fraction: **N 1/2 SE 1/4 SE 1/4** Section Number: **7** Township Number: **T 4 S** Range Number: **R 21 EW**

Distance and direction from nearest town or city street address of well if located within city?
5 MI' SO & WEST OF TROY-KS *dot House 1/82*

2 WATER WELL OWNER: **RALPH WINZER**
 RR#, St. Address, Box #: **405 SIOUX DRIVE**
 City, State, ZIP Code: **OZARKIE-KW 66070**
 Board of Agriculture, Division of Water Resources
 Application Number:

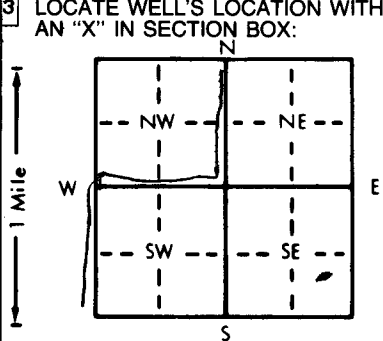

4 DEPTH OF COMPLETED WELL: **45** ft. ELEVATION:ft.
 Depth(s) Groundwater Encountered: 1. **3.5** ft. 2.ft. 3.ft.
 WELL'S STATIC WATER LEVEL: **20** ft. below land surface measured on mo/day/yr **9/17/81**
 Pump test data: Well water wasft. after hours pumping gpm
 Est. Yield: **6** gpm: Well water wasft. after hours pumping gpm
 Bore Hole Diameter: **1.0** in. to **4.0** ft., and **6** in. to **45** ft.
 WELL WATER TO BE USED AS:
 1 Domestic 2 Irrigation 3 Feedlot 4 Industrial 5 Public water supply 6 Oil field water supply 7 Lawn and garden only 8 Air conditioning 9 Dewatering 10 Observation well 11 Injection well 12 Other (Specify below)
 Was a chemical/bacteriological sample submitted to Department? Yes.....No.....**X**.....; If yes, mo/day/yr sample was submitted
 Water Well Disinfected? Yes **X** No

5 TYPE OF BLANK CASING USED:
 1 Steel 2 PVC 3 RMP (SR) 4 ABS 5 Wrought iron 6 Asbestos-Cement 7 Fiberglass 8 Concrete tile 9 Other (specify below) CASING JOINTS: Glued **X** Clamped Welded Threaded
 Blank casing diameter: **6 5/8** in. to **1.2** ft., Dia. **5 PVC** in. to **4.5** ft., Dia.in. toft.
 Casing height above land surface: **1.8** in., weight **15** lbs./ft. Wall thickness or gauge No.
 TYPE OF SCREEN OR PERFORATION MATERIAL:
 1 Steel 2 Brass 3 Stainless steel 4 Galvanized steel 5 Fiberglass 6 Concrete tile 7 PVC 8 RMP (SR) 9 ABS 10 Asbestos-cement 11 Other (specify) 12 None used (open hole)
 SCREEN OR PERFORATION OPENINGS ARE:
 1 Continuous slot 2 Louvered shutter 3 Mill slot 4 Key punched 5 Gauzed wrapped 6 Wire wrapped 7 Torch cut 8 Saw cut 9 Drilled holes 10 Other (specify) 11 None (open hole)
 SCREEN-PERFORATED INTERVALS: From **3.5** ft. to **4.2** ft., Fromft. toft.
 GRAVEL PACK INTERVALS: From **2.0** ft. to **4.5** ft., Fromft. toft.

6 GROUT MATERIAL: 1 Neat cement 2 Cement grout 3 Bentonite 4 Other
 Grout Intervals: From **1.0** ft. to **2.0** ft., Fromft. toft., Fromft. toft.
 What is the nearest source of possible contamination:
 1 Septic tank 2 Sewer lines 3 Watertight sewer lines 4 Lateral lines 5 Cess pool 6 Seepage pit 7 Pit privy 8 Sewage lagoon 9 Feedyard 10 Livestock pens 11 Fuel storage 12 Fertilizer storage 13 Insecticide storage 14 Abandoned water well 15 Oil well/Gas well 16 Other (specify below)
 Direction from well? **N & WEST** How many feet? **500'**

FROM	TO	LITHOLOGIC LOG	FROM	TO	LITHOLOGIC LOG
To 10	3.5	CLAY			
3.5	3.7	MIXED SAND & GRAVEL			
3.7	4.5	SOAP STONE OR SLTAGE			

7 CONTRACTOR'S OR LANDOWNER'S CERTIFICATION: This water well was (1) constructed, (2) reconstructed, or (3) plugged under my jurisdiction and was completed on (mo/day/year) **9/17/81** and this record is true to the best of my knowledge and belief. Kansas Water Well Contractor's License No. **262** This Water Well Record was completed on (mo/day/yr) **6/28/82** under the business name of **MSNEMEE WELL DRILLING** by (signature) *John W. Snemee*