


1	LOCATION OF WATER WELL: County: <u>Washington</u>	Fraction <u>1/4 SE 1/4 NE 1/4</u>	Section Number <u>19</u>	Township Number <u>4</u>	Range Number <u>3</u>
---	--	--------------------------------------	-----------------------------	-----------------------------	--------------------------

Distance and direction from nearest town or city street address of well if located within city?
Linn, 15 East 3-4 miles

2	WATER WELL OWNER: RR#, St. Address, Box #: <u>Stella Ohlde</u> City, State, ZIP Code: <u>8015 Pine Linn, KS 66453</u>	Board of Agriculture, Division of Water Resources Application Number:
---	---	--

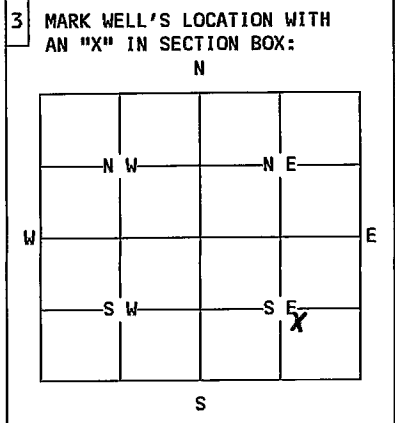

4 DEPTH OF WELL.....28'.....ft.
WELL'S STATIC WATER LEVEL.....13'.....ft.

WELL WAS USED AS:

<input type="radio"/> 1 Domestic	<input type="radio"/> 5 Public Water Supply	<input type="radio"/> 9 Dewatering
<input type="radio"/> 2 Irrigation	<input type="radio"/> 6 Oil Field Water Supply	<input type="radio"/> 10 Monitoring Well
<input type="radio"/> 3 Feedlot	<input type="radio"/> 7 Lawn and Garden Only	<input type="radio"/> 11 Injection Well
<input type="radio"/> 4 Industrial	<input type="radio"/> 8 Air Conditioning	<input type="radio"/> 12 Other.....

Was a chemical/bacteriological sample submitted to Department? Yes.....No.....
if yes, mo/day/yr sample was submitted.....

Water Well Disinfected: Yes No.....

5 TYPE OF BLANK CASING USED:

1 Steel	3 RMP (SR)	5 Wrought	7 Fiberglass	<input checked="" type="radio"/> 9 Other (specify below)
2 PVC	4 ABS	6 Asbestos-Cement	8 Concrete Tile	<u>Hand dug - block rock</u>

Blank casing diameter.....24.....in. Was casing pulled? Yes.....No..... If yes, how much.....2-3 ft.
Casing height above or below land surface.....2 to 3 ft......in. Knocked in

6 GROUT PLUG MATERIAL: 1 Neat cement 2 Cement grout 3 Bentonite 4 Other.....

Grout Plug Intervals: From 3 ft. to 2 1/2 ft., From.....ft. to.....ft., From..... to.....ft.

What is the nearest source of possible contamination:

<input type="radio"/> 1 Septic tank	<input type="radio"/> 6 Seepage pit	<input type="radio"/> 11 Fuel storage	<input checked="" type="radio"/> 16 Other (specify below)
<input type="radio"/> 2 Sewer lines	<input type="radio"/> 7 Pit privy	<input type="radio"/> 12 Fertilizer storage	<u>intermittent stream</u>
<input type="radio"/> 3 Watertight sewer lines	<input type="radio"/> 8 Sewage lagoon	<input type="radio"/> 13 Insecticide storage	
<input type="radio"/> 4 Lateral lines	<input type="radio"/> 9 Feedyard	<input type="radio"/> 14 Abandoned water well	
<input type="radio"/> 5 Cess Pool	<input type="radio"/> 10 Livestock pens	<input type="radio"/> 15 Oil well/Gas well	

Direction from well? South..... How many feet? 300'.....

FROM	TO	PLUGGING MATERIALS
<u>28'</u>	<u>15'</u>	<u>Chlorinated Sand</u>
<u>15'</u>	<u>3'</u>	<u>Clay Soil</u>
<u>3'</u>	<u>2 1/2'</u>	<u>Bentonite</u>
<u>2 1/2'</u>	<u>0'</u>	<u>Topsoil</u>

7 CONTRACTOR'S OR LANDOWNER'S CERTIFICATION: This water well was plugged under my jurisdiction and was completed on (mo/day/year).....4/21/97..... and this record is true to the best of my knowledge and belief. Kansas Water Well Contractor's License No. This Water Well Record was completed on (mo/day/year).....
..... under the business name of Washington County Conservation District
by (signature) Maxine Haman.....

INSTRUCTIONS: Use typewriter or ball point pen. Please press firmly and print clearly. Please fill in blanks, underline or circle the correct answers. Send top three copies to Kansas Department of Health and Environment, Bureau of Water, Topeka, Kansas 66620-0001. Telephone: 913/296-3565. Send one to Water Well Owner and retain one for your records.