


1 LOCATION OF WATER WELL: County: Washington Fraction SE 1/4 SE 1/4 SW 1/4 Section Number 20 Township Number T 4 S Range Number R 3 E/W

Distance and direction from nearest town or city street address of well if located within city? 2 miles west of Linn, KS

2 WATER WELL OWNER: Washington County RWD #2 RR#, St. Address, Box #: 800 S. Oak City, State, ZIP Code: Linn, KS 66953 Board of Agriculture, Division of Water Resources Application Number: N/A

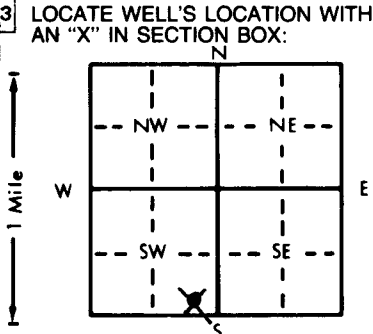

3 LOCATE WELL'S LOCATION WITH AN 'X' IN SECTION BOX: 4 DEPTH OF COMPLETED WELL: 105 ft. ELEVATION: WELL'S STATIC WATER LEVEL: .75 ft. below land surface measured on mo/day/yr 7/24/97

5 TYPE OF BLANK CASING USED: 1 Steel, 3 RMP (SR), 5 Wrought iron, 8 Concrete tile, CASING JOINTS: Glued X, Clamped, 10 Asbestos-cement, 11 Other (specify) 12 None used (open hole)

6 GROUT MATERIAL: 1 Neat cement, 2 Cement grout, X Bentonite, 4 Other Grout Intervals: From 0 ft. to 20 ft.

Table with columns: FROM, TO, LITHOLOGIC LOG, FROM, TO, PLUGGING INTERVALS. Rows include Topsoil, Brown Clay, Sandstone Tan, Blue Shale.

7 CONTRACTOR'S OR LANDOWNER'S CERTIFICATION: This water well was (X) constructed, (2) reconstructed, or (3) plugged under my jurisdiction and was completed on (mo/day/year) 7/24/97 and this record is true to the best of my knowledge and belief.