


1 LOCATION OF WATER WELL: Fraction NE 1/4 NW 1/4 NE 1/4 Section Number 28 Township Number T 4 S Range Number R 3 E/W
 County: Washington

Distance and direction from nearest town or city street address of well if located within city?
1/4 West of Linn, KS.

2 WATER WELL OWNER: Delmar Uffman
 RR#, St. Address, Box # : 1568 8th Rd. Board of Agriculture, Division of Water Resources
 City, State, ZIP Code : Linn, KS. 66953 Application Number:

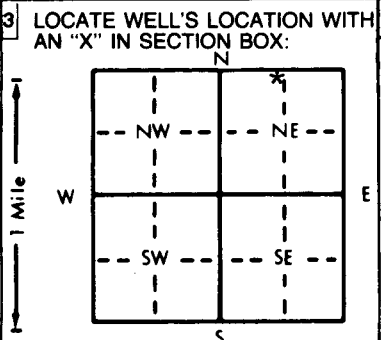

4 DEPTH OF COMPLETED WELL 90 ft. ELEVATION: ft.
 Depth(s) Groundwater Encountered 1. ft. 2. ft. 3. ft.
 WELL'S STATIC WATER LEVEL 47 ft. below land surface measured on mo/day/yr 5/4/01
 Pump test data: Well water was ft. after hours pumping gpm
 Est. Yield 40 gpm: Well water was ft. after hours pumping gpm
 Bore Hole Diameter 9 1/2 in. to 90 ft., and in. to ft.
 WELL WATER TO BE USED AS: 5 Public water supply 8 Air conditioning 11 Injection well
1 Domestic 3 Feedlot 6 Oil field water supply 9 Dewatering 12 Other (Specify below)
 2 Irrigation 4 Industrial 7 Lawn and garden only 10 Monitoring well
 Was a chemical/bacteriological sample submitted to Department? Yes No * If yes, mo/day/yr sample was submitted
 Water Well Disinfected? Yes * No

5 TYPE OF BLANK CASING USED: 5 Wrought iron 8 Concrete tile CASING JOINTS: Glued * Clamped
 1 Steel 3 RMP (SR) 6 Asbestos-Cement 9 Other (specify below) Welded
2 PVC 4 ABS 7 Fiberglass Threaded
 Blank casing diameter 5 in. to 70 ft., Dia in. to ft., Dia in. to ft.
 Casing height above land surface 18 in., weight 200 lbs./ft. Wall thickness or gauge No. .265
 TYPE OF SCREEN OR PERFORATION MATERIAL: 7 PVC 10 Asbestos-cement
 1 Steel 3 Stainless steel 5 Fiberglass 8 RMP (SR) 11 Other (specify)
 2 Brass 4 Galvanized steel 6 Concrete tile 9 ABS 12 None used (open hole)
 SCREEN OR PERFORATION OPENINGS ARE: 5 Gauzed wrapped 8 Saw cut 11 None (open hole)
1 Continuous slot 3 Mill slot 6 Wire wrapped 9 Drilled holes
 2 Louvered shutter 4 Key punched 7 Torch cut 10 Other (specify)
 SCREEN-PERFORATED INTERVALS: From 70 ft. to 90 ft., From ft. to ft.
 From ft. to ft., From ft. to ft.
 GRAVEL PACK INTERVALS: From 30 ft. to 90 ft., From ft. to ft.
 From ft. to ft., From ft. to ft.

6 GROUT MATERIAL: 1 Neat cement 2 Cement grout 3 Bentonite 4 Other
 Grout Intervals: From 5 ft. to 30 ft., From ft. to ft., From ft. to ft.
 What is the nearest source of possible contamination: 10 Livestock pens 14 Abandoned water well
 1 Septic tank 4 Lateral lines 7 Pit privy 11 Fuel storage 15 Oil well/Gas well
 2 Sewer lines 5 Cess pool 8 Sewage lagoon 12 Fertilizer storage 16 Other (specify below)
 3 Watertight sewer lines 6 Seepage pit 9 Feedyard 13 Insecticide storage
 Direction from well? East How many feet? 20

FROM	TO	LITHOLOGIC LOG	FROM	TO	PLUGGING INTERVALS
0	2	Topsoil			
2	14	Tan Clay			
14	16	Ironstone			
16	32	Sandstone & Clay			
32	34	Ironstone			
34	83	Sandstone			
83	91	Gray Shale			

7 CONTRACTOR'S OR LANDOWNER'S CERTIFICATION: This water well was (1) constructed, (2) reconstructed, or (3) plugged under my jurisdiction and was completed on (mo/day/year) 5/4/01 and this record is true to the best of my knowledge and belief. Kansas Water Well Contractor's License No. 518 This Water Well Record was completed on (mo/day/yr) 5/7/01 under the business name of Blue Valley Drilling by (signature) Eric Stark

OFFICE USE ONLY
T
R
EW
SEC.
1/4
1/4
1/4