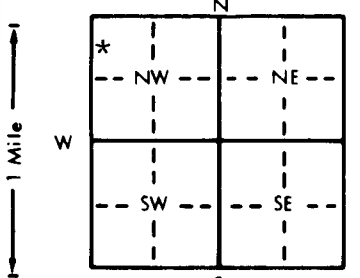


1 LOCATION OF WATER WELL:		Fraction	Section Number		Township Number		Range Number	
County: <u>Washington</u>		<u>NW</u> $\frac{1}{4}$ <u>NW</u> $\frac{1}{4}$ <u>NW</u> $\frac{1}{4}$	<u>36</u>		<u>T</u> <u>4</u> <u>S</u>		<u>R</u> <u>3</u> <u>EW</u>	
Distance and direction from nearest town or city street address of well if located within city? <u>1 1/2 East of Linn, KS</u>								
2 WATER WELL OWNER: <u>Jeff Klewein ATTN. Randy Meyer</u> Well # <u>2</u>								
RR#, St. Address, Box # : <u>1122 National RD</u> Board of Agriculture, Division of Water Resources								
City, State, ZIP Code : <u>Washington KS 66968</u> Application Number:								
3 LOCATE WELL'S LOCATION WITH AN "X" IN SECTION BOX:			4 DEPTH OF COMPLETED WELL <u>82</u> ft. ELEVATION:					
			Depth(s) Groundwater Encountered 1. ft. 2. ft. 3. ft.					
			WELL'S STATIC WATER LEVEL <u>30</u> ft. below land surface measured on mo/day/yr <u>9/5/01</u>					
			Pump test data: Well water was ft. after hours pumping gpm					
			Est. Yield <u>100</u> gpm; Well water was ft. after hours pumping gpm					
			Bore Hole Diameter <u>8 1/2</u> in. to <u>82</u> ft. and in. to ft.					
WELL WATER TO BE USED AS: 5 Public water supply 8 Air conditioning 11 Injection well								
1 Domestic 3 Feedlot 6 Oil field water supply 9 Dewatering 12 Other (Specify below) <u>Livestock</u>								
2 Irrigation 4 Industrial 7 Lawn and garden only 10 Monitoring well								
Was a chemical/bacteriological sample submitted to Department? Yes No <u>8</u> ; If yes, mo/day/yr sample was submitted								
Water Well Disinfected? Yes <u>*</u> No								
5 TYPE OF BLANK CASING USED:								
1 Steel 3 RMP (SR) 5 Wrought iron 8 Concrete tile CASING JOINTS: Glued <u>*</u> Clamped								
2 PVC 4 ABS 6 Asbestos-Cement 9 Other (specify below) Welded								
Blank casing diameter <u>5</u> in. to <u>62</u> ft. Dia. in. to ft. Dia. in. to ft.								
Casing height above land surface <u>18</u> in. weight <u>200</u> lbs./ft. Wall thickness or gauge No. <u>.265</u>								
TYPE OF SCREEN OR PERFORATION MATERIAL:								
1 Steel 3 Stainless steel 5 Fiberglass 7 PVC 10 Asbestos-cement								
2 Brass 4 Galvanized steel 6 Concrete tile 8 RMP (SR) 11 Other (specify)								
SCREEN OR PERFORATION OPENINGS ARE:								
1 Continuous slot 3 Mill slot 5 Gauzed wrapped 8 Saw cut 11 None (open hole)								
2 Louvered shutter 4 Key punched 6 Wire wrapped 9 Drilled holes								
7 Torch cut 10 Other (specify)								
SCREEN-PERFORATED INTERVALS: From <u>62</u> ft. to <u>82</u> ft. From ft. to ft.								
GRAVEL PACK INTERVALS: From <u>30</u> ft. to <u>82</u> ft. From ft. to ft.								
6 GROUT MATERIAL: 1 Neat cement 2 Cement grout 3 Bentonite 4 Other								
Grout Intervals: From <u>5</u> ft. to <u>30</u> ft. From ft. to ft. From ft. to ft.								
What is the nearest source of possible contamination:								
1 Septic tank 4 Lateral lines 7 Pit privy 10 Livestock pens 14 Abandoned water well								
2 Sewer lines 5 Cess pool 8 Sewage lagoon 11 Fuel storage 15 Oil well/Gas well								
3 Watertight sewer lines 6 Seepage pit 9 Feedyard 12 Fertilizer storage 16 Other (specify below)								
13 Insecticide storage								
Direction from well? <u>None Present</u> How many feet?								
FROM	TO	LITHOLOGIC LOG		FROM	TO	PLUGGING INTERVALS		
0	3	Sandy Topsoil						
3	21	Sandstone						
21	27	Light Gray Clay						
27	32	Red Clay						
32	35	Light Gray Clay						
35	82	Sandstone						
7 CONTRACTOR'S OR LANDOWNER'S CERTIFICATION: This water well was (1) <u>constructed</u> , (2) reconstructed, or (3) plugged under my jurisdiction and was completed on (mo/day/year) <u>9/5/01</u> and this record is true to the best of my knowledge and belief. Kansas								
Water Well Contractor's License No. <u>518</u> This Water Well Record was completed on (mo/day/yr) <u>9/9/01</u>								
under the business name of <u>Blue Valley Drilling</u> by (signature) <u>Lin</u>								