


1 LOCATION OF WATER WELL: Fraction SE 1/4 SE 1/4 NE 1/4 Section Number 16 Township Number T 4 S Range Number R 3 E/W
 County: Washington

Distance and direction from nearest town or city street address of well if located within city? 1/2 mile north of Linn on Osage Rd. west side of Rd.

2 WATER WELL OWNER: Larry Schplie
 RR#, St. Address, Box #: 948 Osage Rd. Board of Agriculture, Division of Water Resources
 City, State, ZIP Code: Linn, KS 66953 Application Number:

3 LOCATE WELL'S LOCATION WITH: 4 DEPTH OF COMPLETED WELL 1001 ft. ELEVATION:

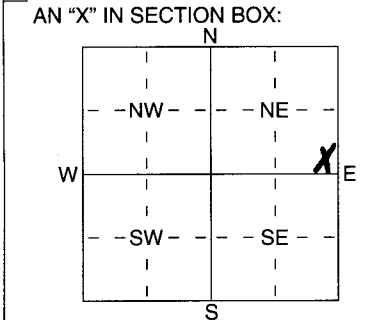

Depth(s) Groundwater Encountered: 1 74 ft. 2 ft. 3 ft.
 WELL'S STATIC WATER LEVEL 90 ft. below land surface measured on mo/day/yr
 Pump test data: Well water was ft. after hours pumping gpm
 Est. Yield 20 gpm: Well water was ft. after hours pumping gpm
 WELL WATER TO BE USED AS: 5 Public water supply 8 Air conditioning 11 Injection well
 1 Domestic 3 Feedlot 6 Oil field water supply 9 Dewatering 12 Other (Specify below)
 2 Irrigation 4 Industrial 7 Domestic (lawn & garden) 10 Monitoring well

Was a chemical/bacteriological sample submitted to Department? Yes No; If yes, mo/day/yr sample was submitted
 Water Well Disinfected? Yes No

5 TYPE OF BLANK CASING USED: 5 Wrought iron 8 Concrete tile CASING JOINTS: Glued Clamped
 1 Steel 3 RMP (SR) 6 Asbestos-Cement 9 Other (specify below) Welded
2 PVC 4 ABS 7 Fiberglass Threaded

Blank casing diameter 5 in. to 8.9 ft. Dia in. to ft. Dia in. to ft.
 Casing height above land surface 2' in., weight Sch 40 lbs./ft. Wall thickness or guage No.

TYPE OF SCREEN OR PERFORATION MATERIAL: 7 PVC 10 Asbestos-Cement
 1 Steel 3 Stainless Steel 5 Fiberglass 8 RMP (SR) 11 Other (Specify)
 2 Brass 4 Galvanized Steel 6 Concrete tile 9 ABS 12 None used (open hole)

SCREEN OR PERFORATION OPENINGS ARE: 5 Guazed wrapped 8 Saw cut 11 None (open hole)
 1 Continuous slot 6 Wire wrapped 9 Drilled holes
 2 Louvered shutter 4 Mill slot 7 Torch cut 10 Other (specify) ft.
 4 Key punched

SCREEN-PERFORATED INTERVALS: From 80 ft. to 100 ft., From ft. to ft.
 From ft. to ft., From ft. to ft.
 GRAVEL PACK INTERVALS: From 25 ft. to 100 ft., From ft. to ft.
 From ft. to ft., From ft. to ft.

6 GROUT MATERIAL: 1 Neat cement 2 Cement grout 3 Bentonite 4 Other
 Grout Intervals: From 3 ft. to 2.5 ft., From ft. to ft., From ft. to ft.

What is the nearest source of possible contamination: 10 Livestock pens 14 Abandoned water well
 1 Septic tank 4 Lateral lines 7 Pit privy 11 Fuel storage 15 Oil well/Gas well
 2 Sewer lines 5 Cess pool 8 Sewage lagoon 12 Fertilizer storage 16 Other (specify below)
 3 Watertight sewer lines 6 Seepage pit 9 Feedyard 13 Insecticide storage

Direction from well? North West How many feet? 120'

FROM	TO	LITHOLOGIC LOG	FROM	TO	PLUGGING INTERVALS
0	1	Top Soil			
1	17	Brown Clay			
17	19	Sand			
19	26	Brown Clay			
26	43	Sand Stone			
43	74	Tan Clay			
74	90	Sand Stone			
90	100'	Grey Shale			

7 CONTRACTOR'S OR LANDOWNER'S CERTIFICATION: This water well was (1) constructed, (2) reconstructed, or (3) plugged under my jurisdiction and was completed on (mo/day/year) 4/6/2004 and this record is true to the best of my knowledge and belief. Kansas Water Well Contractor's Licence No 451 This Water Well Record was completed on (mo/day/yr) 5/11/2004 under the business name of Haldiman Well Drilling by (signature) Craig W. CNDRE