


1 LOCATION OF WATER WELL: County: Washington Fraction: SE 1/4 SE 1/4 SW 1/4 Section Number: 20 Township Number: T 4 S Range Number: R 3 E/W

Distance and direction from nearest town or city street address of well if located within city?  
Well is located 2100ft. East & 400 Ft. North of Southwest Corner of Section

2 WATER WELL OWNER: Washington Co. RWD #2 1 3/4 Miles West of Linn, Ks.  
 RR#, St. Address, Box # : c/o Schwab-Eaton P.A. Board of Agriculture, Division of Water Resources  
 City, State, ZIP Code : 1125 Garden Way Manhattan, Ks. 66502 Application Number: #34253

3 LOCATE WELL'S LOCATION WITH AN "X" IN SECTION BOX:

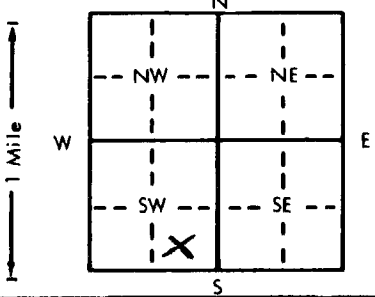

4 DEPTH OF COMPLETED WELL... 115 ft. ELEVATION: 1400  
 Depth(s) Groundwater Encountered 1. 55 ft. 2. 55 ft. 3. 55 ft.  
 WELL'S STATIC WATER LEVEL ... 55 ft. below land surface measured on mo/day/yr 10/14/85  
 Pump test data: Well water was 92 ft. after 8 hours pumping 165 gpm  
 Est. Yield ... 165 gpm: Well water was 92 ft. after 8 hours pumping 165 gpm  
 Bore Hole Diameter: 12 in. to 117 ft., and 117 in. to 117 ft.  
 WELL WATER TO BE USED AS:  
 5 Public water supply 8 Air conditioning 11 Injection well  
 1 Domestic 3 Feedlot 6 Oil field water supply 9 Dewatering 12 Other (Specify below)  
 2 Irrigation 4 Industrial 7 Lawn and garden only 10 Observation well  
 Was a chemical/bacteriological sample submitted to Department? Yes.....No. X.....; If yes, mo/day/yr sample was submitted  
 Water Well Disinfected? Yes X No

5 TYPE OF BLANK CASING USED:  
 1 Steel 3 RMP (SR) 5 Wrought iron 8 Concrete tile CASING JOINTS: Glued ..... Clamped .....  
 2 PVC 4 ABS 6 Asbestos-Cement 9 Other (specify below) Welded X .....  
 7 Fiberglass ..... Threaded.....

Blank casing diameter ... 8 in. to 95 ft., Dia. .... in. to .... ft., Dia. .... in. to .... ft.  
 Casing height above land surface... 12 in., weight 24.7 lbs./ft. Wall thickness or gauge No. 288

TYPE OF SCREEN OR PERFORATION MATERIAL:  
 1 Steel 3 Stainless steel 5 Fiberglass 7 PVC 10 Asbestos-cement  
 2 Brass 4 Galvanized steel 6 Concrete tile 8 RMP (SR) 11 Other (specify) .....  
 12 None used (open hole)

SCREEN OR PERFORATION OPENINGS ARE:  
 1 Continuous slot 3 3/16 in. slot 5 Gauzed wrapped 8 Saw cut 11 None (open hole)  
 2 Louvered shutter 4 Key punched 6 Wire wrapped 9 Drilled holes  
 7 Torch cut 10 Other (specify) .....

SCREEN-PERFORATED INTERVALS: From 95 ft. to 115 ft., From ..... ft. to ..... ft.  
 GRAVEL PACK INTERVALS: From 25 ft. to 115 ft., From ..... ft. to ..... ft.

6 GROUT MATERIAL: 1 Neat cement 2 Cement grout 3 Bentonite 4 Other .....  
 Grout Intervals: From 5 ft. to 25 ft., From ..... ft. to ..... ft.

What is the nearest source of possible contamination:  
 1 Septic tank 4 Lateral lines 7 Pit privy 10 Livestock pens 14 Abandoned water well  
 2 Sewer lines 5 Cess pool 8 Sewage lagoon 11 Fuel storage 15 Oil well/Gas well  
 3 Watertight sewer lines 6 Seepage pit 9 Feedyard 12 Fertilizer storage 16 Other (specify below)  
 13 Insecticide storage

Direction from well? NONE WITHIN 1 mile How many feet?

FROM	TO	LITHOLOGIC LOG	FROM	TO	LITHOLOGIC LOG
0	3	Top Soil			
3	6	Sand Rock			
6	22	Red Sandstone			
22	58	Brown Sandstone			
58	114	Light Brown Sandstone			
114	115	Hard Sand Rock			
115	117	Gray Shale			

7 CONTRACTOR'S OR LANDOWNER'S CERTIFICATION: This water well was (1) constructed, (2) reconstructed, or (3) plugged under my jurisdiction and was completed on (mo/day/year) Oct 14, 1985 and this record is true to the best of my knowledge and belief. Kansas Water Well Contractor's License No. 138 This Water Well Record was completed on (mo/day/yr) Nov 5, 1985 under the business name of Peterson, Irrigation, Inc. by (signature) Mike Peterson

INSTRUCTIONS: Use typewriter or ball point pen, PLEASE PRESS FIRMLY and PRINT clearly. Please fill in blanks, underline or circle the correct answers. Send top three copies to Kansas Department of Health and Environment, Division of Environment, Environmental Geology Section, Topeka, KS 66620. Send one to WATER WELL OWNER and retain one for your records.

OFFICE USE ONLY  
T  
R  
EW  
SEC.