

MW6


1 LOCATION OF WATER WELL: County: WASHINGTON Fraction: NE 1/4 NE 1/4 NE 1/4 Section Number: 9 Township Number: 4 Range Number: 4 EW

Distance and direction from nearest town or city street address of well if located within city?

5th AND MAIN GREENLEAF

2 WATER WELL OWNER: Greenleaf COOP Board of Agriculture, Division of Water Resources
RR#, St. Address, Box #: PO BOX 303 Application Number:
City, State, ZIP Code: Greenleaf, KS 66943

3 LOCATE WELL'S LOCATION WITH AN "X" IN SECTION BOX:

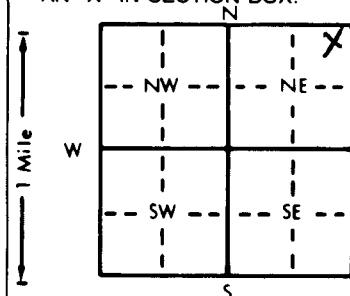

4 DEPTH OF COMPLETED WELL: 45 ft. ELEVATION: 1411.79
Depth(s) Groundwater Encountered 1. 38 ft. 2. ft. 3. ft.

WELL'S STATIC WATER LEVEL 37.22 ft. below land surface measured on mo/day/yr 6/21/01

Pump test data: Well water was ft. after hours pumping gpm

Est. Yield gpm: Well water was ft. after hours pumping gpm

Bore Hole Diameter: 8.5 in. to 4.5 ft., and .in. to .ft.

WELL WATER TO BE USED AS: 5 Public water supply 8 Air conditioning 11 Injection well

1 Domestic 3 Feedlot 6 Oil field water supply 9 Dewatering 12 Other (Specify below)

2 Irrigation 4 Industrial 7 Lawn and garden only 10 Monitoring wellWas a chemical/bacteriological sample submitted to Department? Yes. No. X; If yes, mo/day/yr sample was submittedWater Well Disinfected? Yes No No

5 TYPE OF BLANK CASING USED: 5 Wrought iron 8 Concrete tile CASING JOINTS: Glued Clamped

1 Steel 3 RMP (SR) 6 Asbestos-Cement 9 Other (specify below) Welded

2 PVC 4 ABS 7 Fiberglass Threaded

Blank casing diameter 2 in. to 30 ft., Dia. in. to .ft., Dia. in. to .ft.Casing height above land surface -4.08 in., weight 0.8 lbs./ft. Wall thickness or gauge No. SCH 40

TYPE OF SCREEN OR PERFORATION MATERIAL: 7 PVC 10 Asbestos-cement

1 Steel 3 Stainless steel 5 Fiberglass 8 RMP (SR) 11 Other (specify)

2 Brass 4 Galvanized steel 6 Concrete tile 9 ABS 12 None used (open hole)

SCREEN OR PERFORATION OPENINGS ARE: 5 Gauzed wrapped 8 Saw cut 11 None (open hole)

1 Continuous slot 3 Mill slot 6 Wire wrapped 9 Drilled holes

2 Louvered shutter 4 Key punched 7 Torch cut 10 Other (specify)

SCREEN-PERFORATED INTERVALS: From 30 ft. to 45 ft., From .ft. to .ft.

From .ft. to .ft., From .ft. to .ft.

GRAVEL PACK INTERVALS: From 28 ft. to 45 ft., From .ft. to .ft.

From .ft. to .ft., From .ft. to .ft.

6 GROUT MATERIAL: 1 Neat cement 2 Cement grout 3 Bentonite 4 Other

Grout Intervals: From 1 ft. to 26 ft., From 26 ft. to 28 ft., From .ft. to .ft.

What is the nearest source of possible contamination: 10 Livestock pens 14 Abandoned water well

1 Septic tank 4 Lateral lines 7 Pit privy 11 Fuel storage 15 Oil well/Gas well

2 Sewer lines 5 Cess pool 8 Sewage lagoon 12 Fertilizer storage 16 Other (specify below)

3 Watertight sewer lines 6 Seepage pit 9 Feedyard 13 Insecticide storage LUST SITE

Direction from well? How many feet?

FROM TO LITHOLOGIC LOG FROM TO PLUGGING INTERVALS

0 15 SILTY CLAY


15 21 SANDY CLAY

21 45 FINE SAND



Washington County

9-4-4E



N

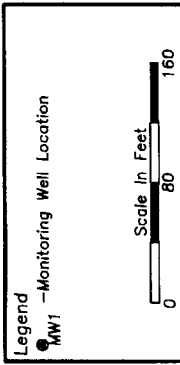



Area Base Map
Farmer Coop Elevator
Greenleaf, KS
Upgrade Report
CGP Project #01212
Prepared By: RH Date: 05-31-16
Reviewed By: MK Date: 06-20-16
Figure 1
CGP, Inc. PO Box 23, Wahos, NE 68066

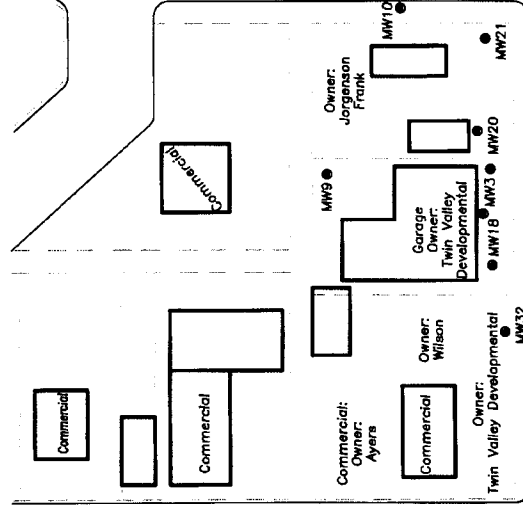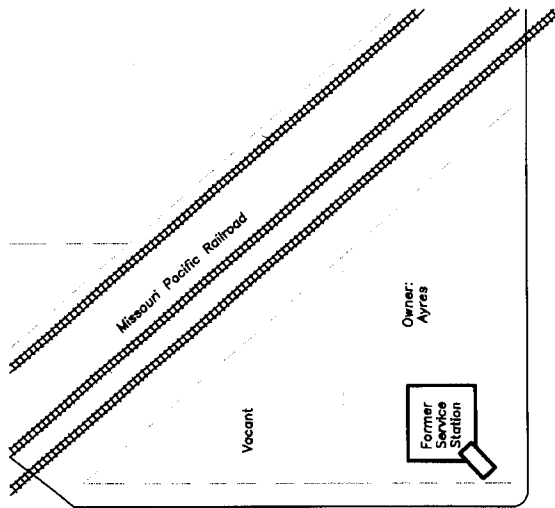

Fifth Street

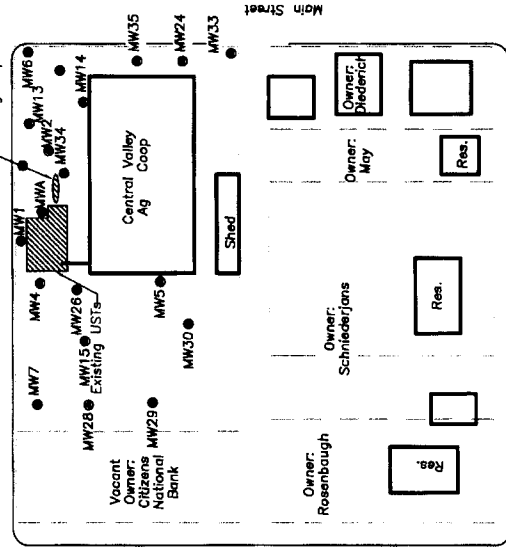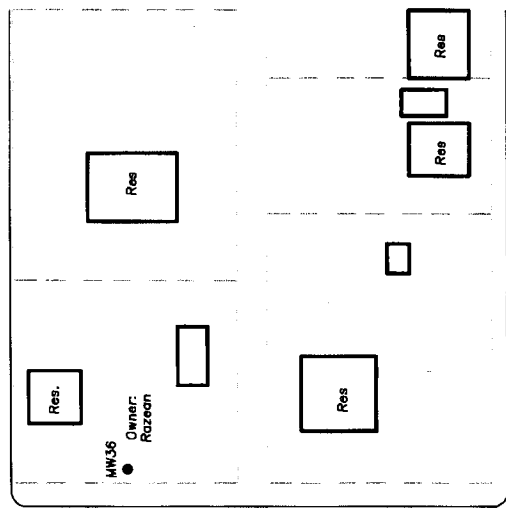

Commercial Street

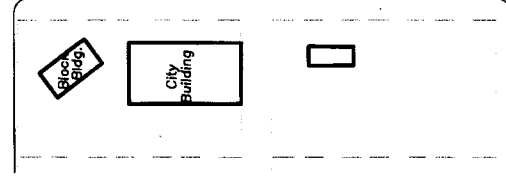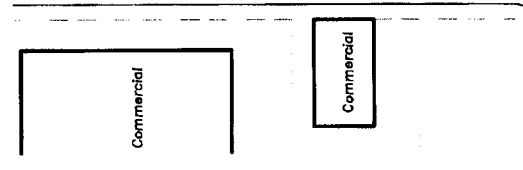

Sixth Street