


[illegible]



Washington County

9-4-4E



N

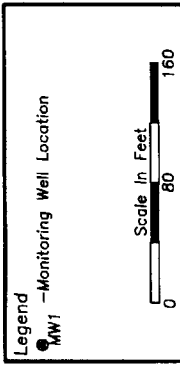


Area Base Map
Farmer Coop Elevator
Greenleaf, KS
Upgrade Report
CGP Project #01212
Prepared By: RH Date: 05-31-16
Reviewed By: MK Date: 06-20-16
Figure 1
CGP, Inc. PO Box 23, Wahar, NE 68066

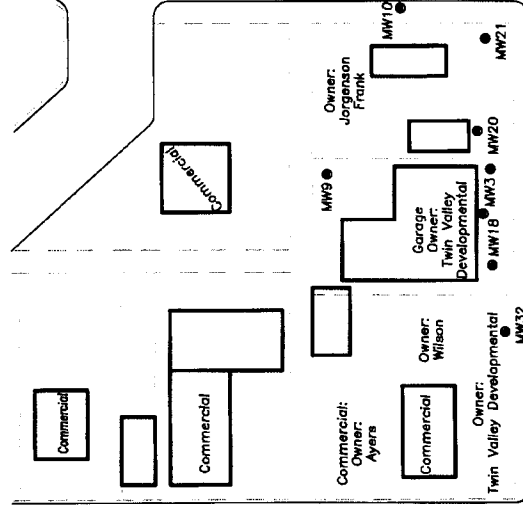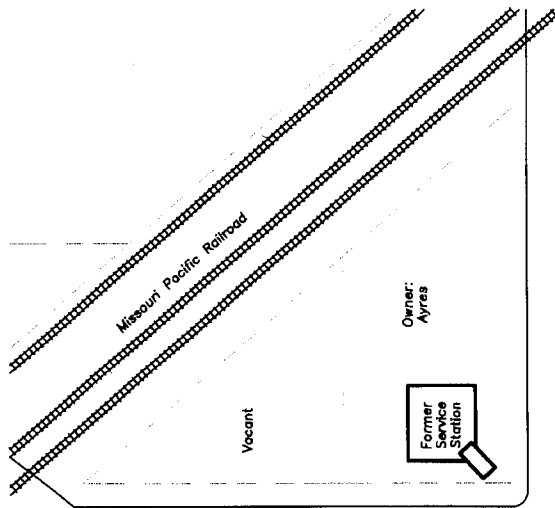

Fifth Street

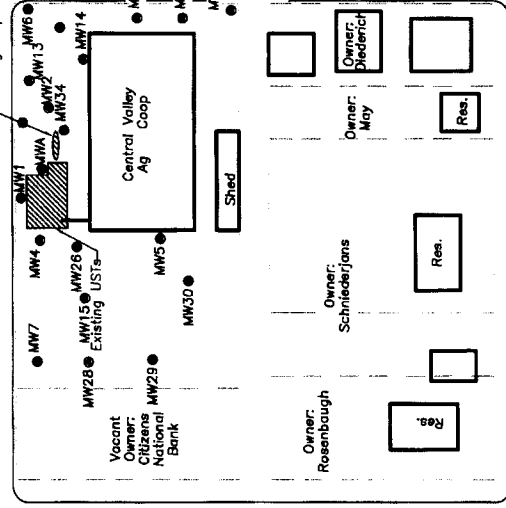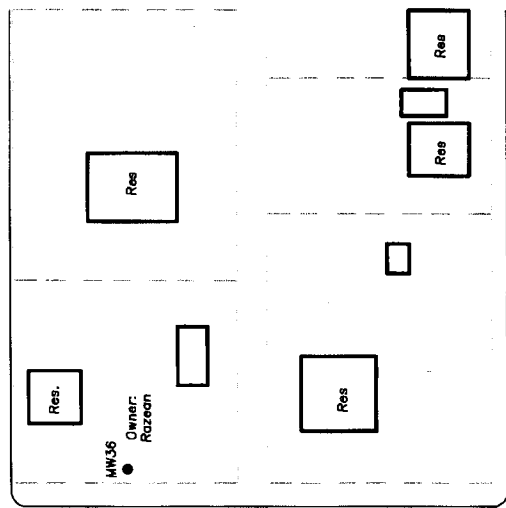

Commercial Street

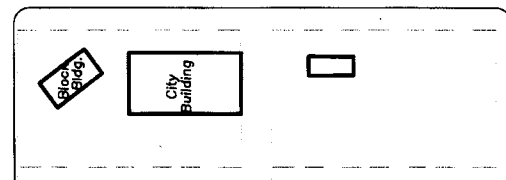

Sixth Street