


Distance and direction from nearest town or city street address of well if located within city?Application Number: N/A

AN "X" IN SECTION BOX:



From ft. to ft. From ft. to ft.

How many feet?

0	3	TOPSOIL
3	40	BRN CLAY W/SHALE
40	55	BRN SILT
55	90	BRN CLAY W/SHALE
90	105	BRN GRAVEL
105	130	BRN CLAY W/SHALE
130	135	LIMESTONE

INSTRUCTIONS: Use typewriter or ball point pen. PLEASE PRESS FIRMLY and PRINT clearly. Please fill in blanks, underline or circle the correct answers. Send top three copies to Kansas Department of Health and Environment, Bureau of Water, Geology Section, 1000 SW Jackson St., Suite 420, Topeka, Kansas 66612-1367. Telephone 785-296-5522. Send one to WATER WELL OWNER and retain one for your records. Fee of \$5.00 for each constructed well.