9C

USE TYPEWRITER OR BALL POINT PEN-PRESS FIRMLY, PRINT CLEARLY.

T 4S R 5E EW sec 1/4 1/4 1/4 No.

WATER WELL RECORD
KSA 82a-1201-1215

Kansas State Dept. Of Health
(Water Well Contractors)
Forbes-Bldg. 740
Topeka, Kansas 66620

1 Location of well:	County	Township name	Fraction	Section number	Town number	Range number
	Washington	Barnes (Banner)	SE ¼	16	4	5 E

Distance and direction from nearest town or city: ½ Mi East of Barnes

Street address of well location if in city:

3 Owner of well: FRED BROWN

Address: Barnes, Kansas

Locate with "X" in section below:

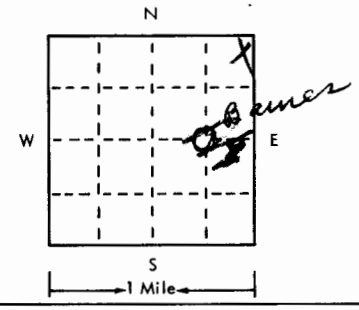

Sketch map:

2 Type and color of material	From	To
Top Soil	0	6
Yellow Clay	7	27
Yellow Limestone	28	32
Red Clay	33	82
Coarse Limestone Water at 90'	83	95
Blue Shale	96	101

(use a second sheet if needed)

4 Well depth: 101 ft. Date of completion April 10
Well diameter 6 in.

5 [X] Cable tool [ ] Rotary [ ] Driven [ ] Dug [ ] Hollow rod [ ] Jetted [ ] Bored [ ] Reverse rotary

6 Use: [X] Domestic [ ] Public supply [ ] Industry [ ] Irrigation [ ] Air conditioning [ ] Commercial [ ] Test well [ ]

7 Casing: Material RMP Height: above/~~below~~
Threaded [ ] Welded [ ] Surface 15 in. 250 wt
Diam. 5 in. to 101 ft. depth Weight ~~40~~ lbs./ft.
Drive shoe? [ ] Yes [X] No
in. to ft. depth

8 Screen:
Manufacturer Pump Co
Type RMP 80 Dia. 5" I.D.
Slot/gauze Length 20'
Set between 80 ft. and 101 ft.
Fittings:
Gravel pack [X] Yes [ ] No Size range of material ¼ X ¼"

9 Static water level:
85 ft. below land surface Date after 10-75

10 Pumping level below land surfaces:
ft. after hrs. pumping g.p.m.
ft. after hrs. pumping g.p.m.
Estimated maximum yield 10 g.p.m. Bailer test

11 Water sample submitted:
[ ] Yes [X] No Date

12 Well head completion: N A
[ ] Pitless adapter [ ] Inches above grade

13 Well grouted? [X] Yes [ ] No
[X] Neat cement [ ] Bentonite [ ]
Depth: From 20 ft. to 9 ft.

14 Nearest source of possible contamination:
ft. 75 Direction east Type Septic tank
Well disinfected upon completion? [X] Yes [ ] No

15 Pump: [X] Not installed
Manufacturer's name
Model number HP Volts
Length of drop pipe ft. capacity g.m.p.
Type:
[ ] Submersible [ ] Turbine
[ ] Jet [ ] Reciprocating
[ ] Certrifugal [ ] Other

16 Remarks: elevation 1300'

Topography:
[ ] Hill
[ ] Slope
[ ] Upland
[X] Valley

17 Water well contractor's certification:
This well was drilled under my jurisdiction and this report is true to the best of my knowledge and belief.
Business name Strader Drilling Co. License No. 237
Address Blue Rapids,
Signed Harold Strader Date 4-12-75
Authorized representative

Forward the white, blue and pink copies to the Kansas State Dept. Of Health.

Form WWC-5

677-H