


USE TYPEWRITER OR BALL POINT PEN-PRESS FIRMLY, PRINT CLEARLY.

WATER WELL RECORD T45
KSA 82a-1201-1215

Kansas Department of Health and Environment-Division of Environment (Water well Contractors) Topeka, Kansas 66620

Location of well: **Marshall** County
 Fraction: **North East 1/4** Section number: **15**
 Township number: **T 2 South** Range number: **R 6 East** E/W

Distance and direction from nearest town or city: **Waterville**
 Street address of well location if in city: **2 mi north, 1 1/2 mi east, 1 mi south, 1/2 east**
 3. Owner of well: **Dale Stewart**
 R.R. or street: **Waterville Kans**
 City, state, zip code: **Waterville Kans**

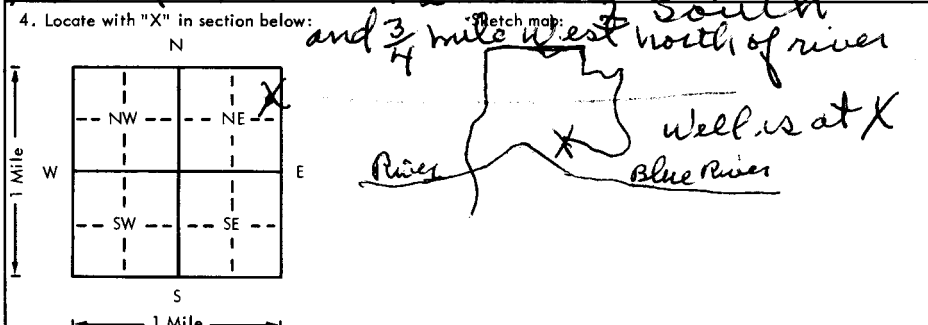

6. Bore hole dia. **4** in. Completion date **12-8-76**
 Well depth **57** ft.
 7. Cable tool Rotary Driven Dug
 Hollow rod Jetted Bored Reverse rotary
 8. Use: Domestic Public supply Industry
 Irrigation Air conditioning Stock
 Lawn Oil field water Other
 9. Casing: Material **Steel** Height: Above or below
 Threaded Welded Surface **48** in.
 RMP PVC Weight **13** lbs./ft.
 Dia. **6 1/2** in. to **41** ft. depth Wall Thickness: **2.6** in. wall
 Dia. **6** in. to **41** ft. depth Log No. **X**

5. Type and color of material	From	To
top soil	0	2
clay Brown	2	5
clay gravelly mixed	5	30
Sand coarse	30	35
gravel, coarse	35	41
Limestone Porrous	41	54
Blue Shale	54	57

10. Screen: Manufacturer's name **Pumflo**
 Type **PVC** Dia. **6" inside**
 Slot/groove **0.40** Length **20**
 Set between **37** ft. and **57** ft.
 Gravel pack? Size range of material **4X4**
 11. Static water level: **30** ft. below land surface Date **12-8-76**
 12. Pumping level below land surfaces:
 _____ ft. after _____ hrs. pumping _____ g.p.m.
 _____ ft. after _____ hrs. pumping _____ g.p.m.
 Estimated maximum yield **40** g.p.m.
 13. Water sample submitted: _____ mo./day/yr.
 Yes No Date _____
 14. Well head completion: **NA**
 Pitless adapter _____ inches above grade
 15. Well grouted?
 With: Neat cement Bentonite Concrete
 Depth: From **14** ft. to **4** ft.
 16. Nearest source of possible contamination:
 ft. **1350** Direction **SOUTH** Type **RIVER**
 Well disinfected upon completion? Yes No
 17. Pump: Not installed
 Manufacturer's name _____
 Model number _____ HP _____ Volts _____
 Length of drop pipe _____ ft. capacity _____ g.p.m.
 Type:
 Submersible Turbine
 Jet Reciprocating
 Centrifugal Other

18. Elevation: _____
 19. Remarks: _____
 Topography:
 Hill
 Slope
 Upland
 Valley
 20. Water well contractor's certification:
 This well was drilled under my jurisdiction and this report is true to the best of my knowledge and belief.
Straders Drilling Co. 23
 Business name License No. _____
 Address **Blue Rapids**
 Signed **Harold Stradel** Date **12-10-76**
 Authorized representative